


T. 7S., R. 38E., W.M.

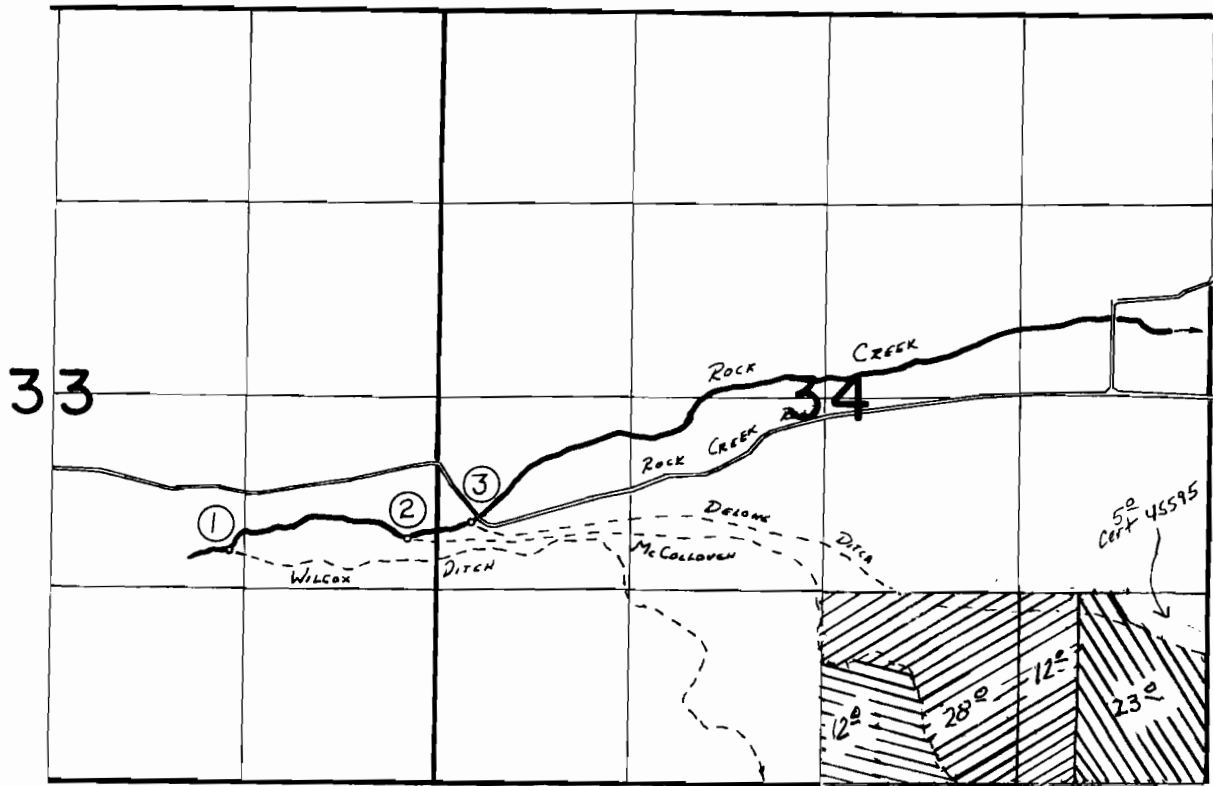

1. Wilcox Ditch Div. Pt. Loc: 1580'N. & 1430'W. FROM SE CORNER SECTION 33
2. McCULLOUGH Ditch Div. Pt. Loc: 1670'N. & 200'W. FROM SE CORNER SECTION 33
3. DeLONG Ditch Div. Pt. Loc: 1790'N. & 230'E. FROM SW CORNER SECTION 34

FINAL PROOF SURVEY

UNDER

TRANSFER 3688

IN NAME OF

.....BILL & MARY.....DETHLOFF.....

	1882
	1868
	1904



SCALE 1" = 1320'

Surveyed 8-5..... 1983, by V.L. Church.....