
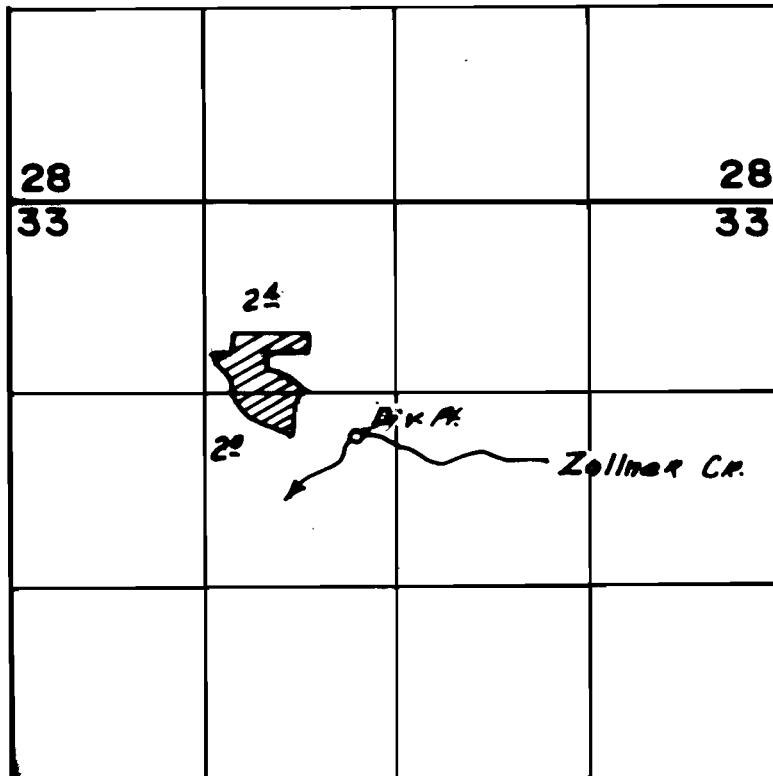


T.5S.R.1W.,W.M.

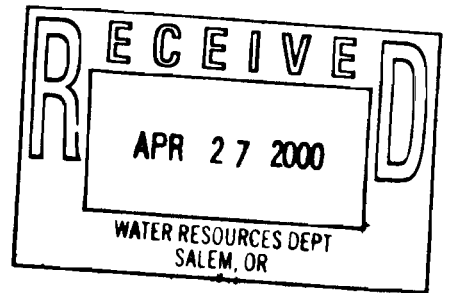

Scale  
4"=1 Mi.

Div. Pt. loc. 1630'S & 2340'E from NW COR Sec 33

**FINAL PROOF SURVEY  
UNDER**

Transfer No. T-7935


Application No. .... Permit No. ....

IN NAME OF

ROBERT FESSLER

THIS MAP WAS PREPARED FOR THE  
PURPOSE OF IDENTIFYING THE LOCA-  
TION OF A WATER RIGHT ONLY AND IS  
NOT INTENDED TO PROVIDE LEGAL  
DIMENSIONS OR LOCATION OF PROPER-  
TY OWNERSHIP LINES.

Surveyed Mar. 29 2000 by .....

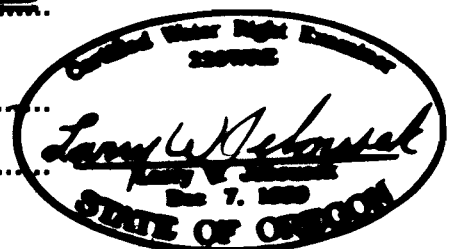

WAC MARION CO-92 76-6