


Section 9, T.4S. R.1E. W.M.
CLACKAMAS COUNTY

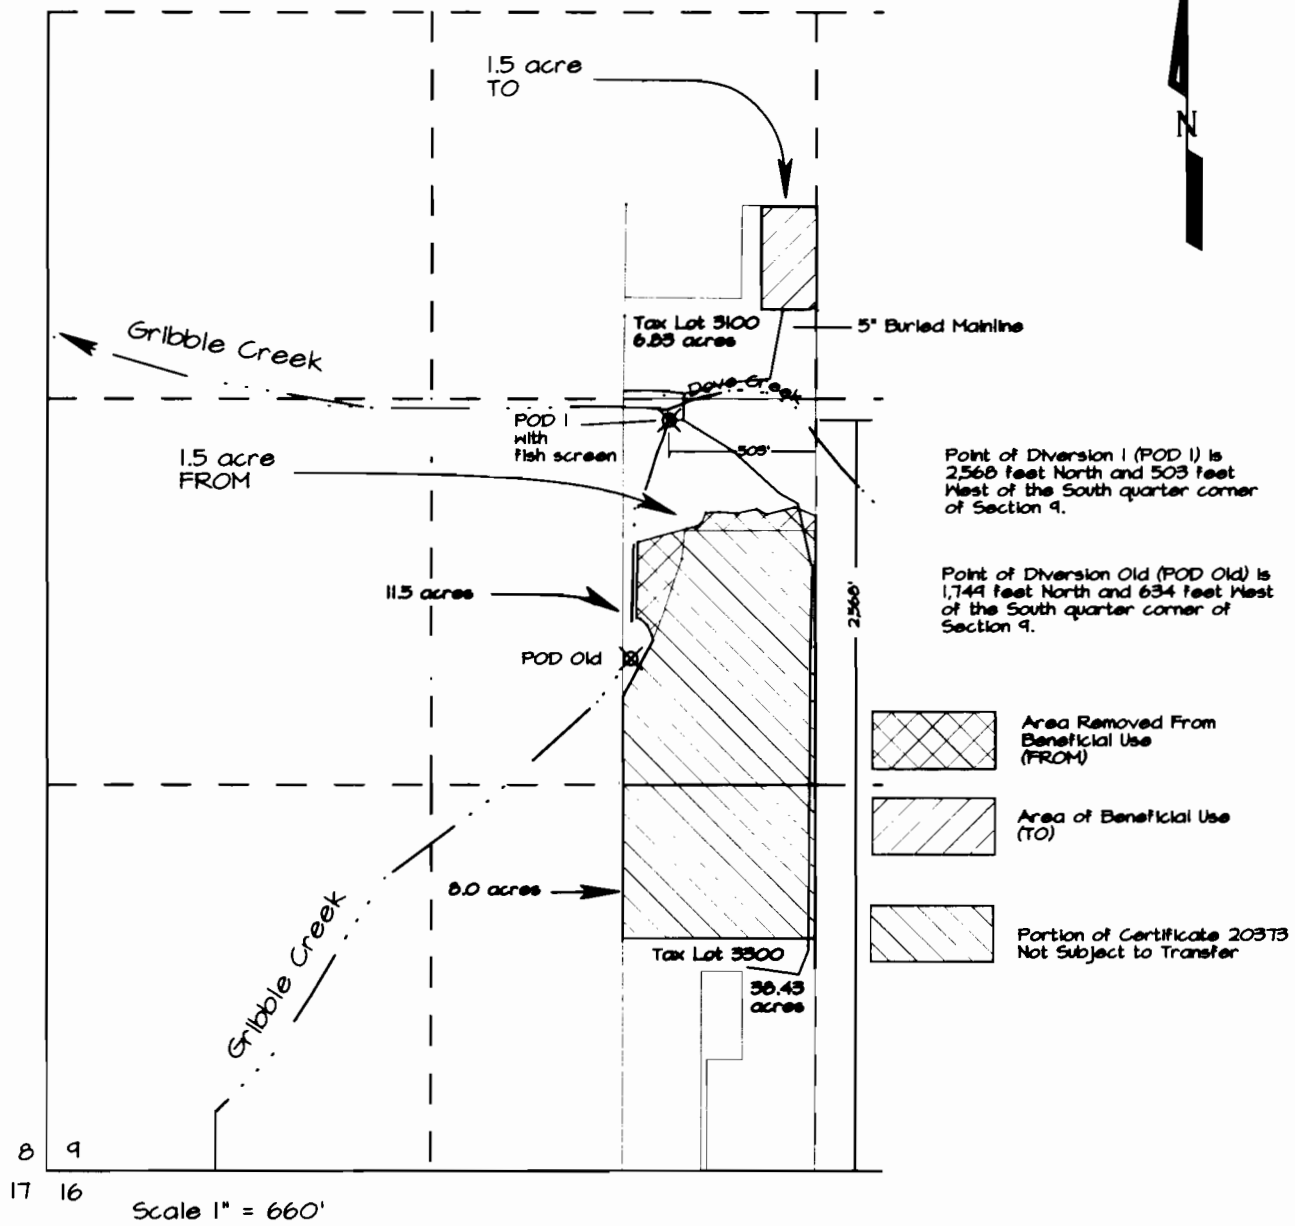

RECEIVED

JAN 27 2012

WATER RESOURCES DEPT
SALEM, OREGON

CLAIM OF BENEFICIAL USE MAP
FOR TRANSFER T-8008

Ramon Demartini
8441 S. Lone Elder Road
Canby, Oregon 97013



RENEWS 12-31-2013

THE PREPARATION OF THIS MAP IS FOR THE PURPOSE OF IDENTIFYING THE LOCATION OF THE WATER RIGHT ONLY AND HAS NO INTENT TO PROVIDE DIMENSIONS OR LOCATION OF PROPERTY OWNERSHIP LINES.