


FINAL PROOF MAP

TO ADD TWO POINTS OF DIVERSION AND A RESERVOIR FOR PERMITS S-53933 AND R-13649

TOWNSHIP 3 NORTH, RANGE 4 WEST, SECTION 17, W.M.
TAX LOT: 5700

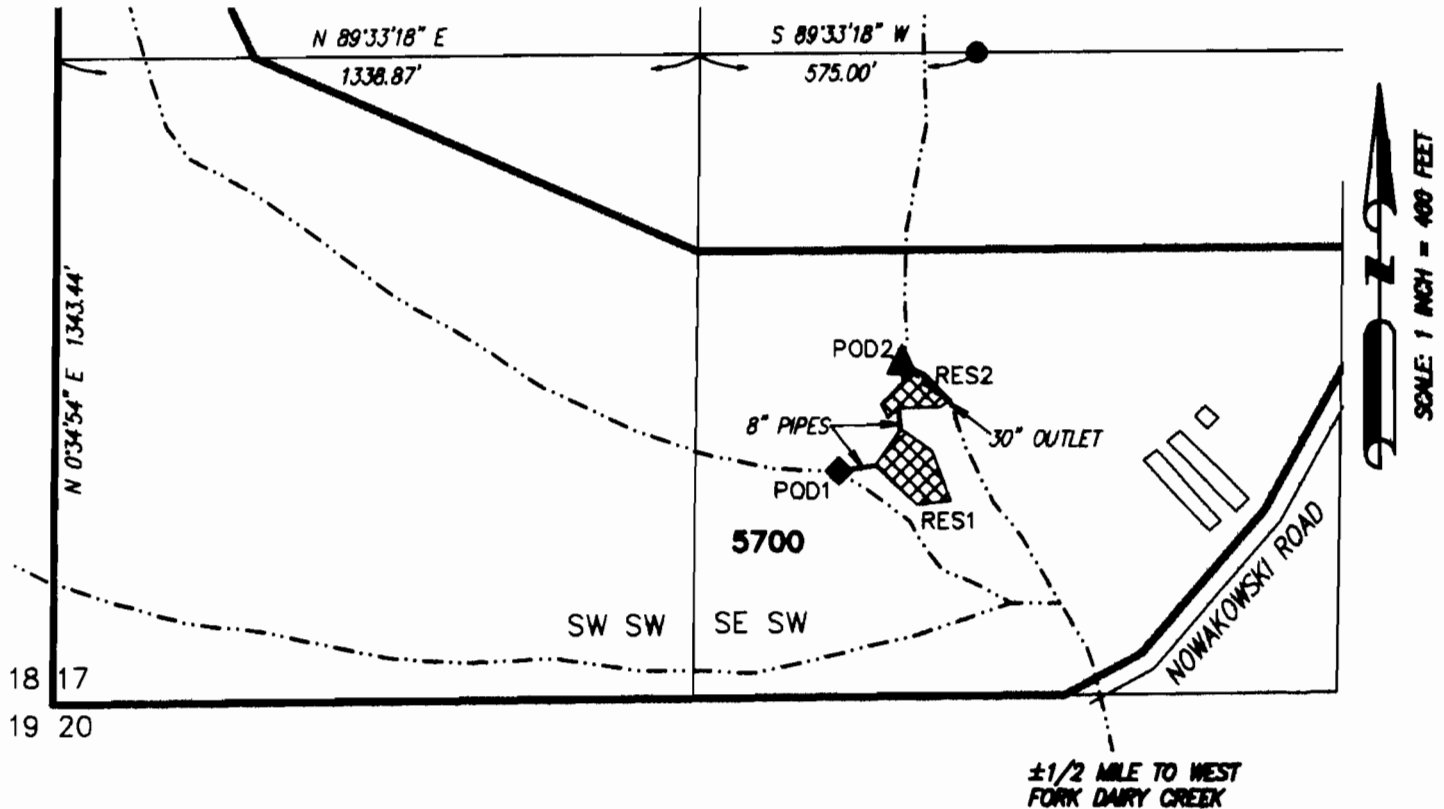

◆ **POD1 (OFF-STREAM)**

PIPE DIVERSION IN THE SE1/4 OF THE SW1/4 OF SECTION 17
LOCATED 487 FEET NORTH AND 1041 FEET EAST FROM THE SW
1/4 CORNER OF SECTION 17, TOWNSHIP 3 NORTH, RANGE 4
WEST, W.M., WASHINGTON COUNTY, OREGON

▲ **POD2 (IN-STREAM)**

INSTREAM DIVERSION IN THE SE1/4 OF THE SW1/4 OF
SECTION 17 LOCATED 711 FEET NORTH AND 1771 FEET EAST
FROM THE SW 1/4 CORNER OF SECTION 17, TOWNSHIP 3
NORTH, RANGE 4 WEST, W.M., WASHINGTON COUNTY, OREGON

● **FOUND SURVEY MONUMENT**

XXXXXX 2.1 ACRE-FT RESERVOIR, AS SHOWN

----- UNNAMED STREAM



RENEWAL DATE: 12/31/2012

THIS MAP IS FOR THE PURPOSE OF LOCATING A WATER
RIGHT ONLY AND HAS NO INTENT TO PROVIDE LEGAL
DIMENSIONS OR THE LOCATION OF PROPERTY LINES

PREPARED FOR:

THOMAS TIBBS
6070 SW 190TH
ALOHA, OR 97007

PREPARED BY:



ALL POINTS ENGINEERING AND SURVEYING, INC.
P.O. BOX 767 (CRR) TERREBONNE, OR 97760
(541) 548-5833
www.APEandS.com