


SUPERSEDING


T 2 S R 38 E

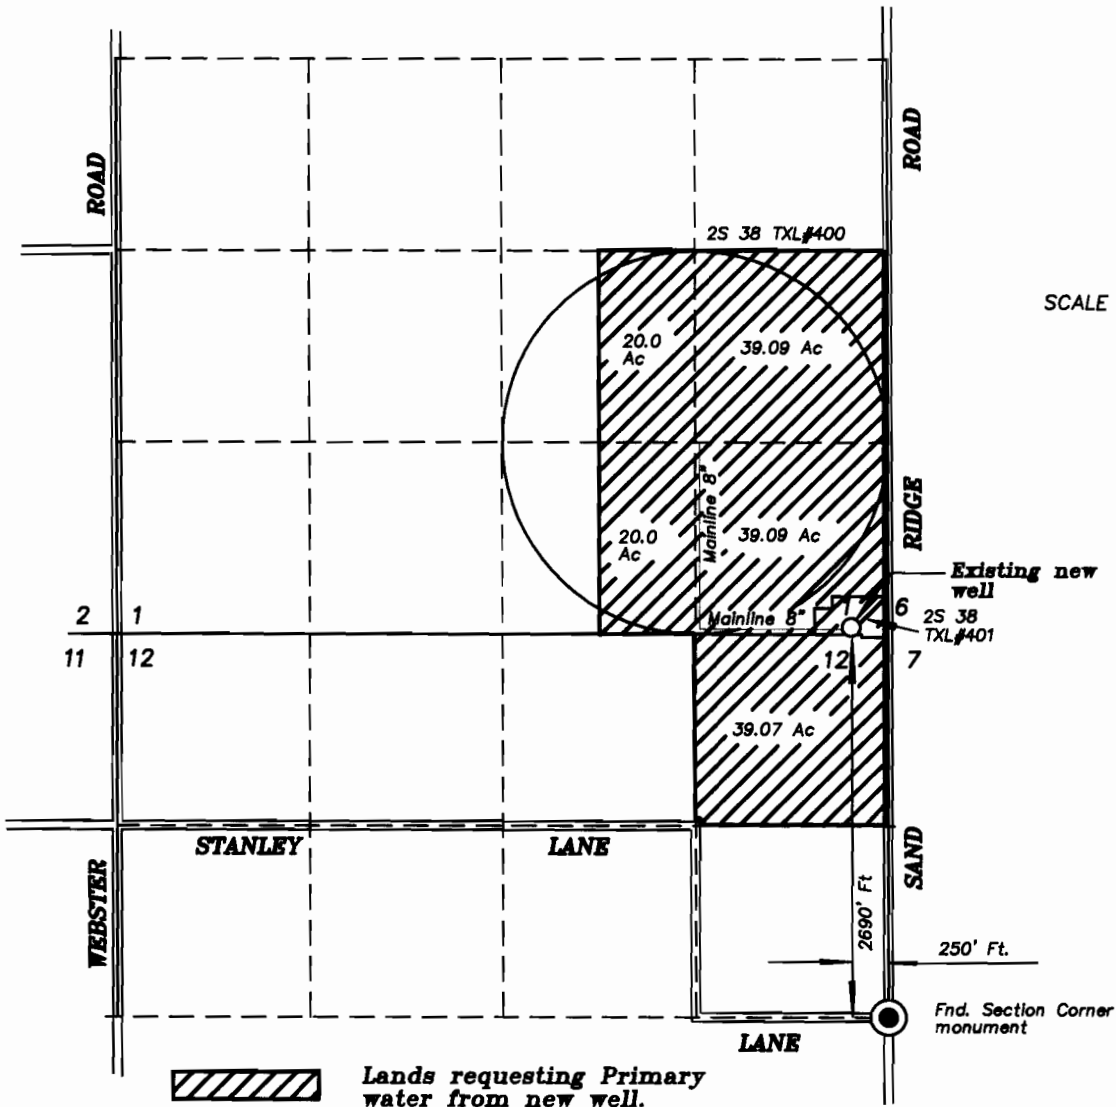

SCALE 1" = 1320'

Lands requesting Primary water from new well.

Mainline

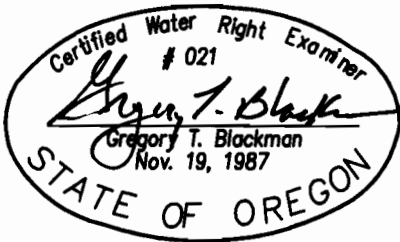

NOTE: The preparation of this map was for the purpose of identifying the location of water rights and has no intent to provide dimensions or location of property ownership lines. Location information shown hereon was furnished by the applicant.

SUPERSEDING
**FINAL PROOF MAP OF
 WATER RIGHTS
 FOR
 JOHN C. CUTHBERT AND
 MARITA CUTHBERT**

BY
**BAGETT - GRIFFITH & BLACKMAN
 2006 ADAMS AVENUE
 LAGRANDE, OREGON 97850**

January 11, 2013

RECEIVED BY OWRD

APPLICATION NO.

G- 14024

PERMIT NUMBER

G- 12651

JAN 14 2013

SALEM, OR