


LEGEND

	PRIMARY IRRIGATION PER PERMIT S-72390 AND SUPPLEMENTAL IRRIGATION PER TRANSFER T-6728
	PROPERTY BOUNDARY LINE
	TAX LOT LINE
	1/16TH SECTION
	EXISTING WATER MAIN PIPES
	HYDRANT
	RESTROOM

CLAIM OF BENEFICIAL USE MAP

SECTIONS 11 & 12, T2N, R3W, WM
LOTS 100 & 200 OF TAX MAP 2N 3W 11 &
LOT 300 OF TAX MAP 2N 3W 12
WASHINGTON COUNTY, OREGON
TRANSFER T-6728
APPLICATION R-72389 / PERMIT R-13789
APPLICATION S-72390 / PERMIT S-53992

PREPARED FOR:
ROBERT D. HORNING AND
JANE A. HORNING
21277 NW BRUNSWICK CANYON RD.
NORTH PLAINS, OREGON 97133

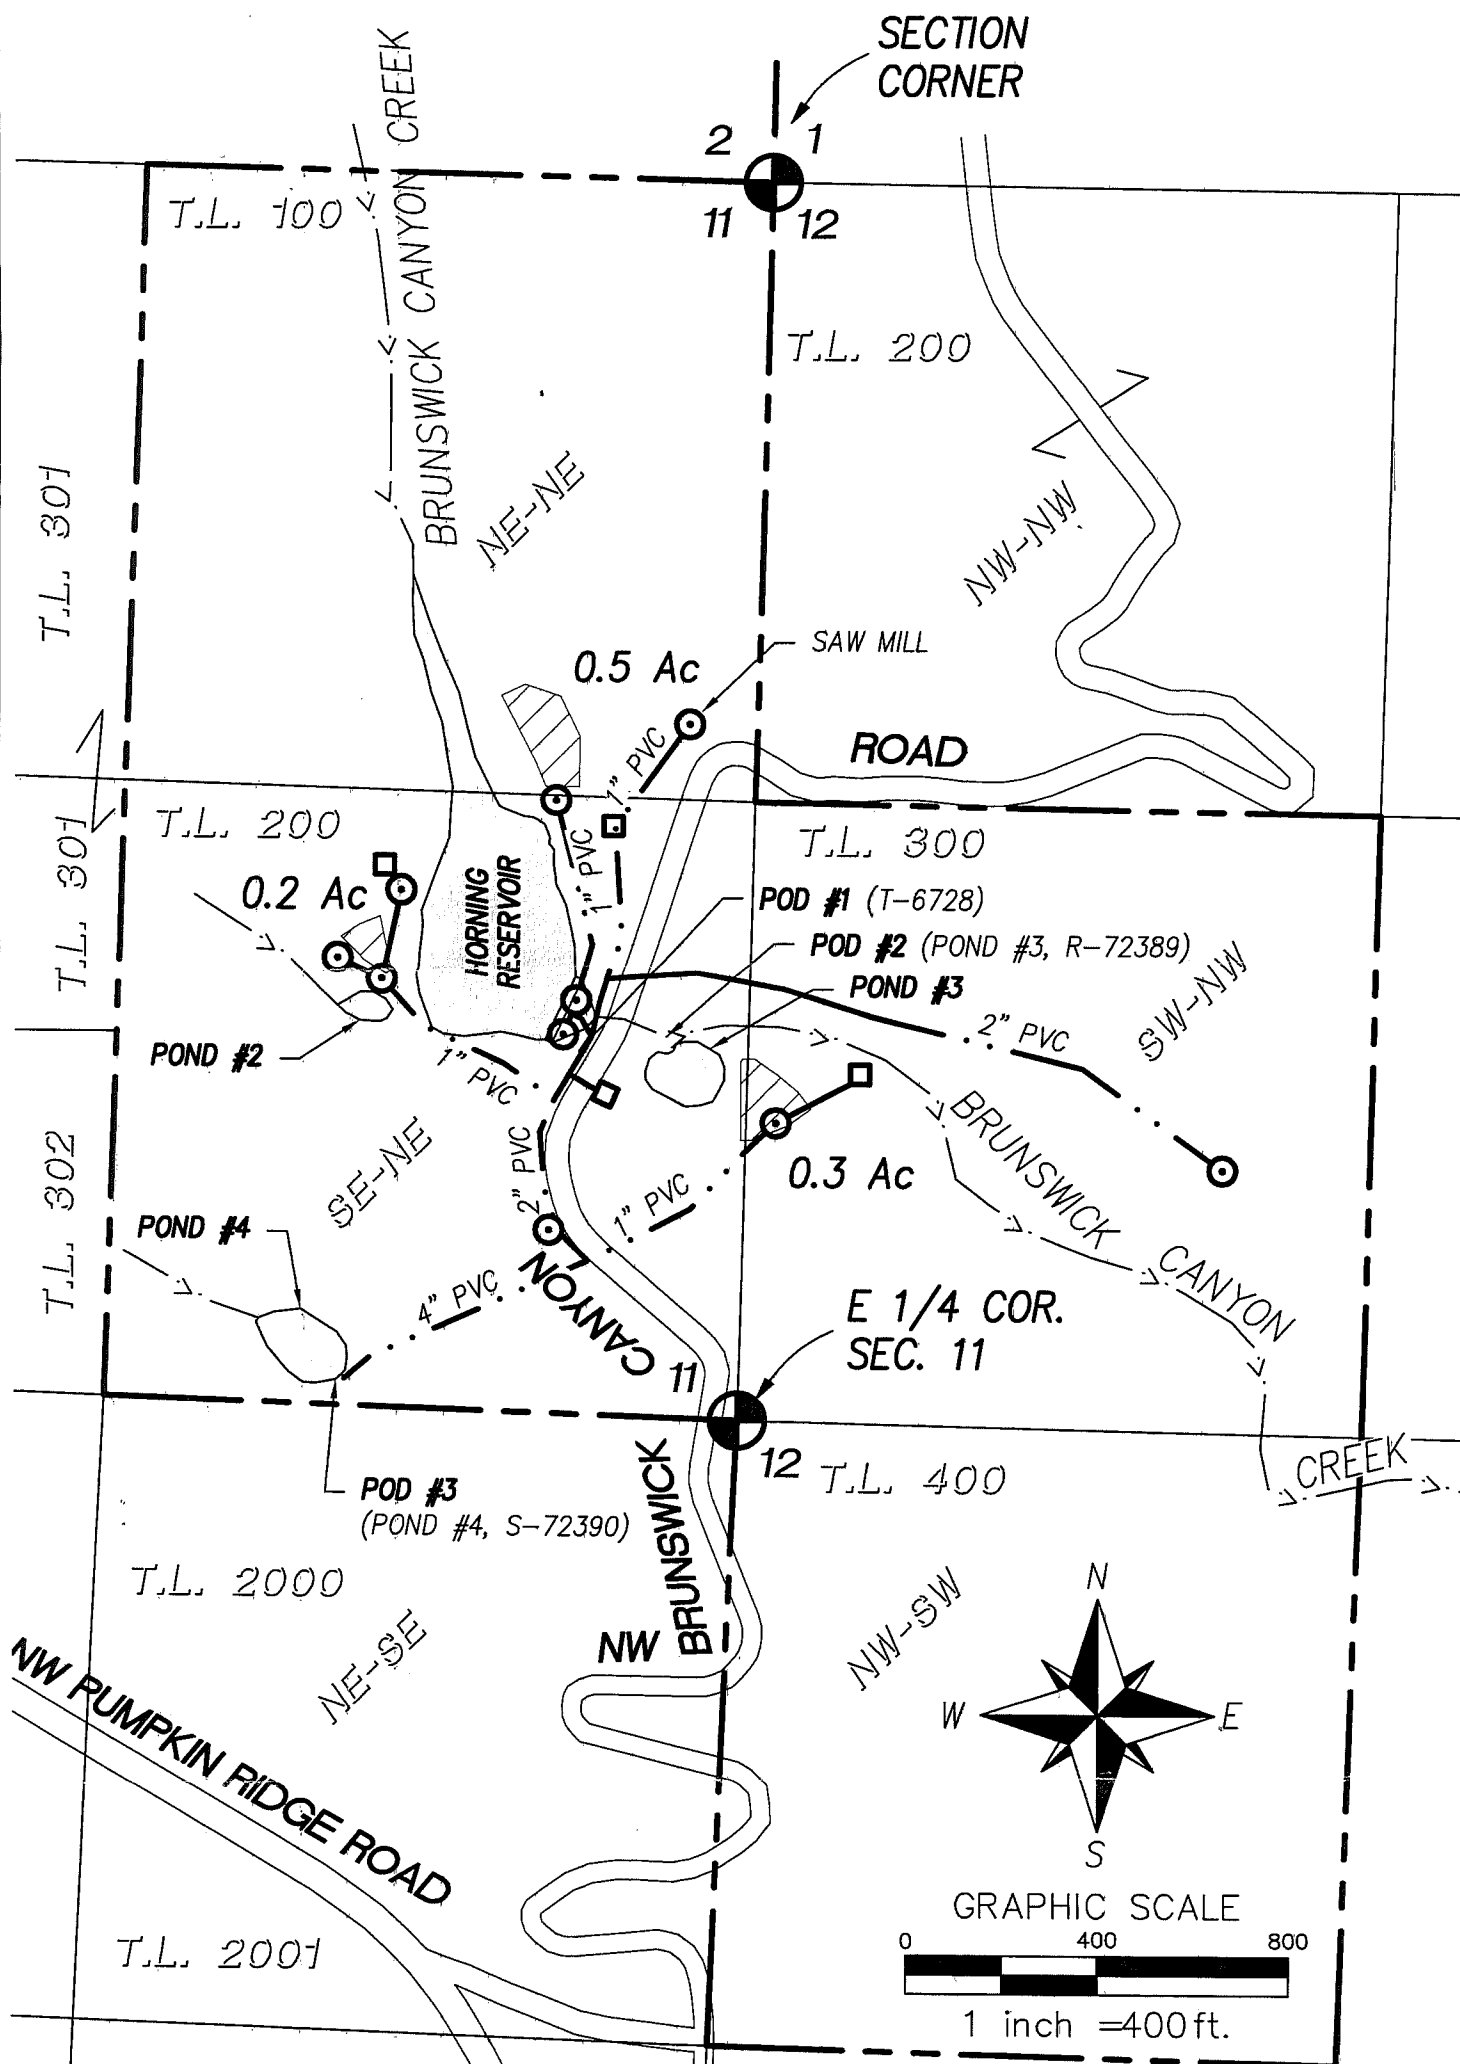

RESERVOIR AND POD LOCATIONS

FROM E 1/4 CORNER
OF SECTION 11

HORNING RESERVOIR
860' NORTH 370' WEST

POND #2
860' NORTH 720' WEST

POND #3
780' NORTH 60' WEST

POND #4
80' NORTH 840' WEST

POD #1
770' NORTH 330' WEST


POD #2
800' NORTH 150' WEST

POD #3
80' NORTH 840' WEST

RECEIVED BY OWRD

SEP 07 2012

SALEM, OR

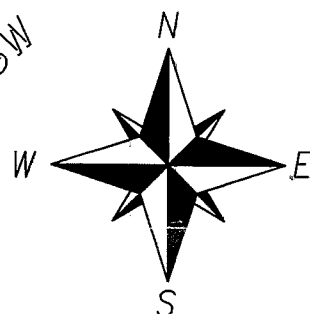

GRAPHIC SCALE



1 inch = 400 ft.

COBU MAP # 702

MAP BASES: WASHINGTON COUNTY TAX MAPS 2N 3W SEC. 11 AND 2N 3W SEC. 12
2011 AERIAL PHOTO FROM GOOGLE EARTH

THIS MAP WAS PREPARED FOR THE PURPOSE OF IDENTIFYING THE LOCATION OF A WATER
RIGHT ONLY AND IS NOT INTENDED TO PROVIDE LEGAL DIMENSIONS OR LOCATION OF
PROPERTY OWNERSHIP LINES.



EXPIRES : 12-31-2012

Stuntzner
Engineering
& Forestry, LLC

* COOS BAY * DALLAS *
* FOREST GROVE *

Project: 310-2-026
By: Kaid E. McKay
Date: August 5, 2012