

Scale: 1" = 200 ft.

New point of diversion is 1,110 ft. South & 510 ft. West of the North 1/4 corner of Section 17.



Existing point of diversion is 1,370 ft. South & 400 ft. West of the North 1/4 corner of Section 17.

CLAIM OF BENEFICIAL USE OF A WATER RIGHT TRANSFER, PERMIT NO. 33826, in the NW 1/4 of Section 17, T26S, R4W, W.M., Douglas County, Oregon

**Transfer No. 8165
Permit No. 33862, App. No. 45306**

**For: Evan Sitton
2211 Whistlers Bend Park Road
Roseburg, Oregon 97470**

**By: Shaner Engineering, Inc.
P.O. Box 1430
Roseburg, Oregon 97470**

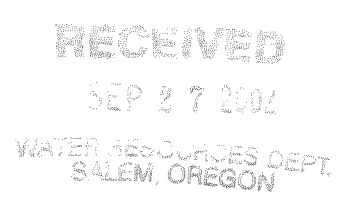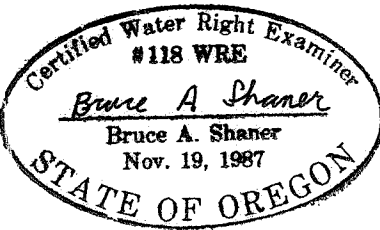

August 17, 2002