


# FINAL PROOF SURVEY MAP for T-6772

## JELD-WEN

Timber & Ranches  
T 37 S R 11 1/2 E, W.M.

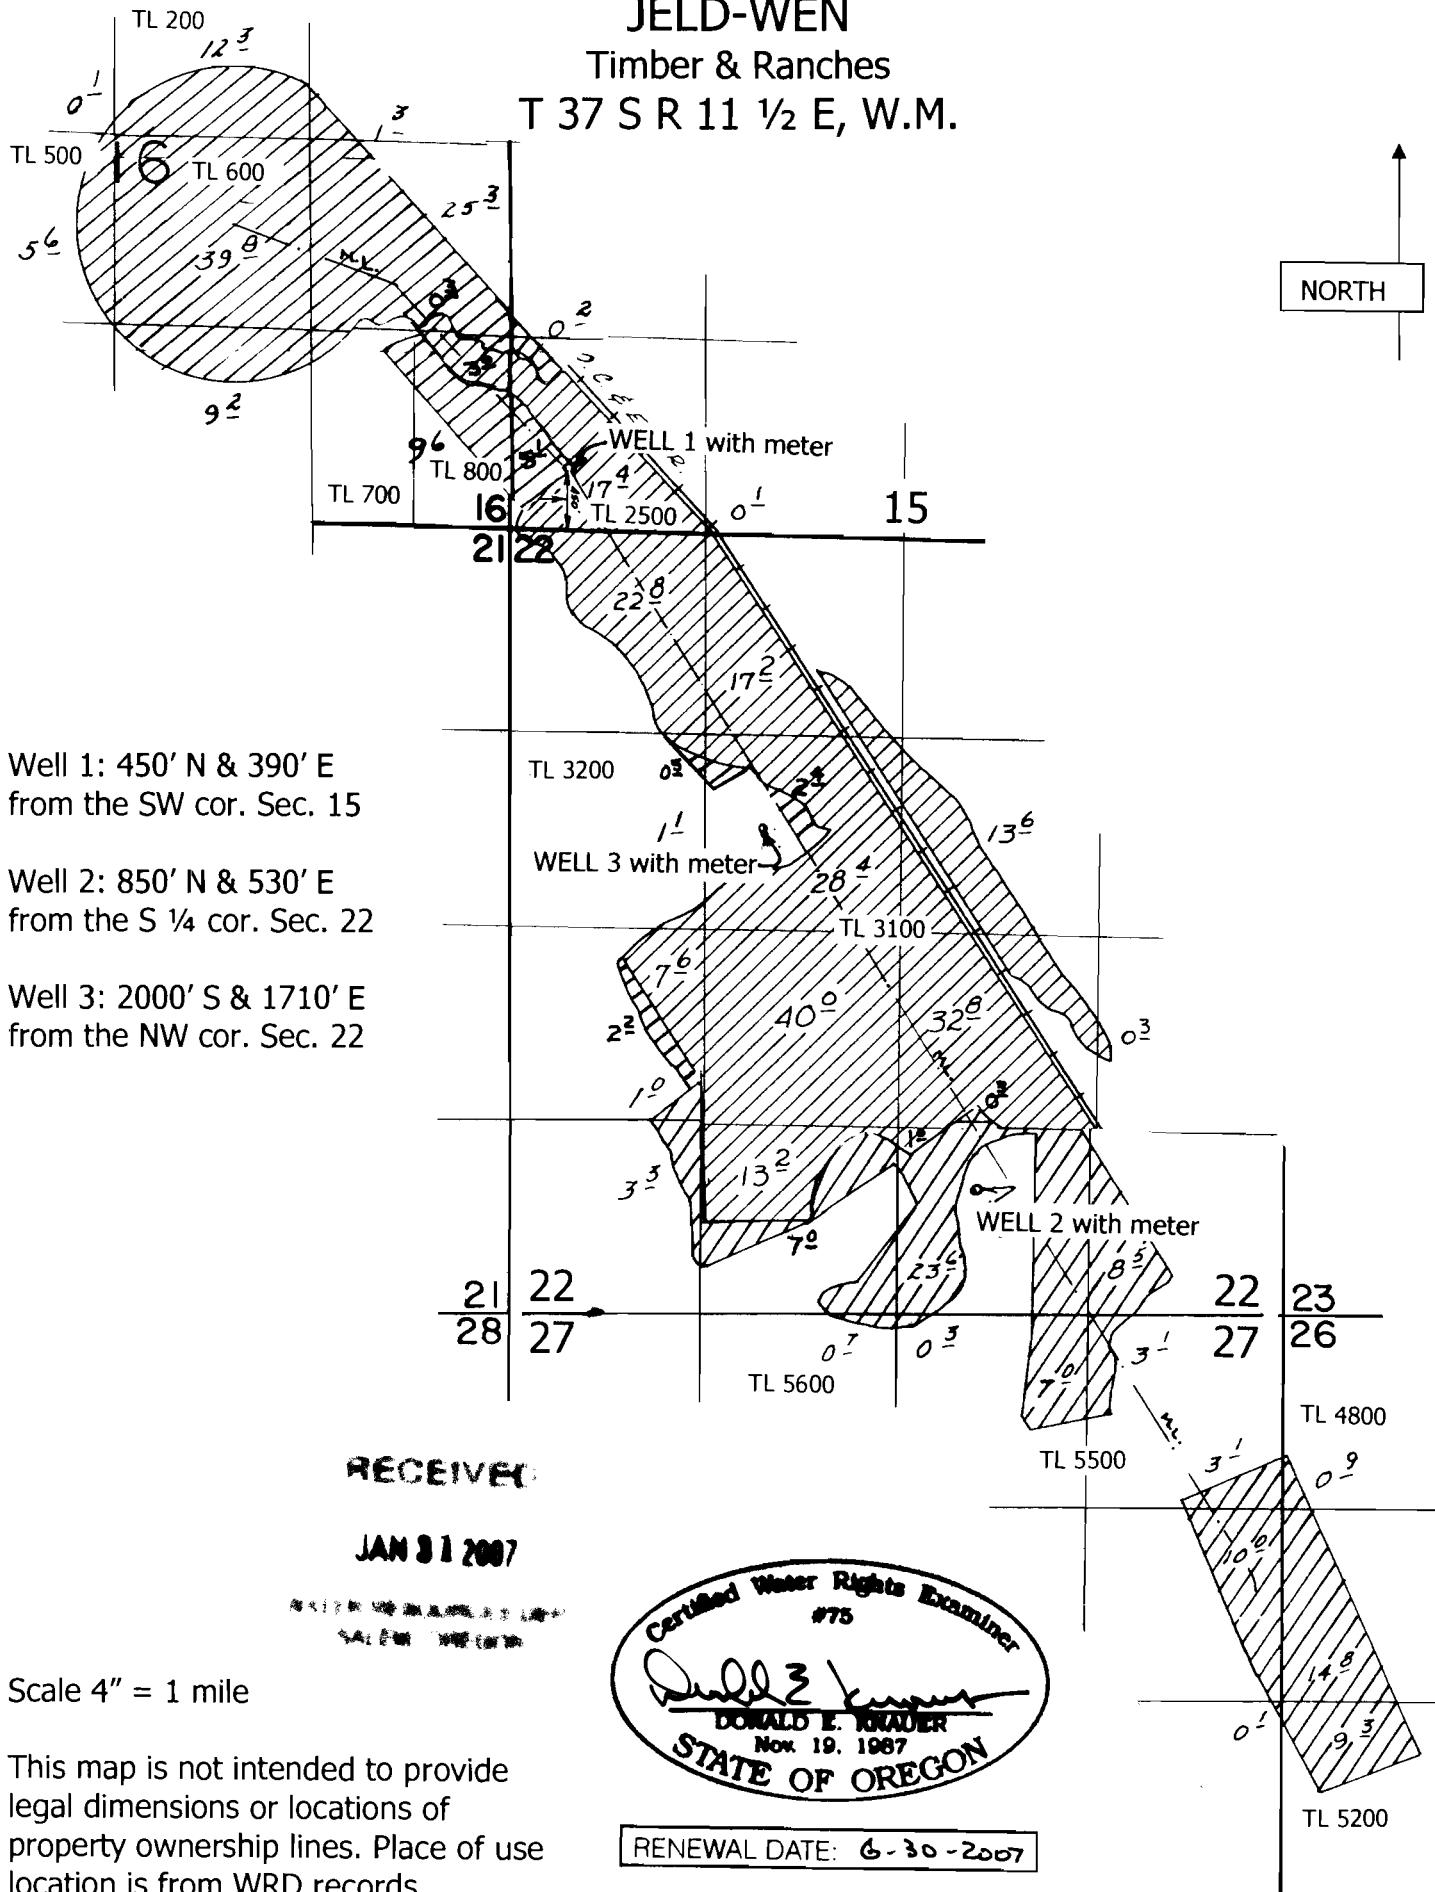

Well 1: 450' N & 390' E  
from the SW cor. Sec. 15

Well 2: 850' N & 530' E  
from the S 1/4 cor. Sec. 22

Well 3: 2000' S & 1710' E  
from the NW cor. Sec. 22


RECEIVED

JAN 31 2007


Scale 4" = 1 mile

This map is not intended to provide legal dimensions or locations of property ownership lines. Place of use location is from WRD records.

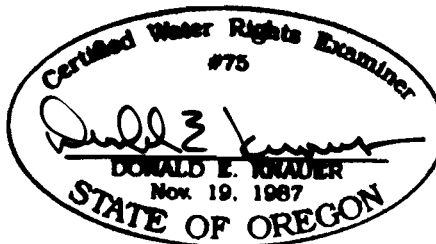

RENEWAL DATE: 6-30-2007