


CLAIM OF BENEFICIAL USE
FOR: PAULETTO RANCH LLC
BY DUANE W. KIRBY
T26S, R7W, WM SECTION 3
T-10632

TAX LOT 1800
FISH SCREEN IS LOCATED AT THE POD
METER IS LOCATED 40' FROM THE POD

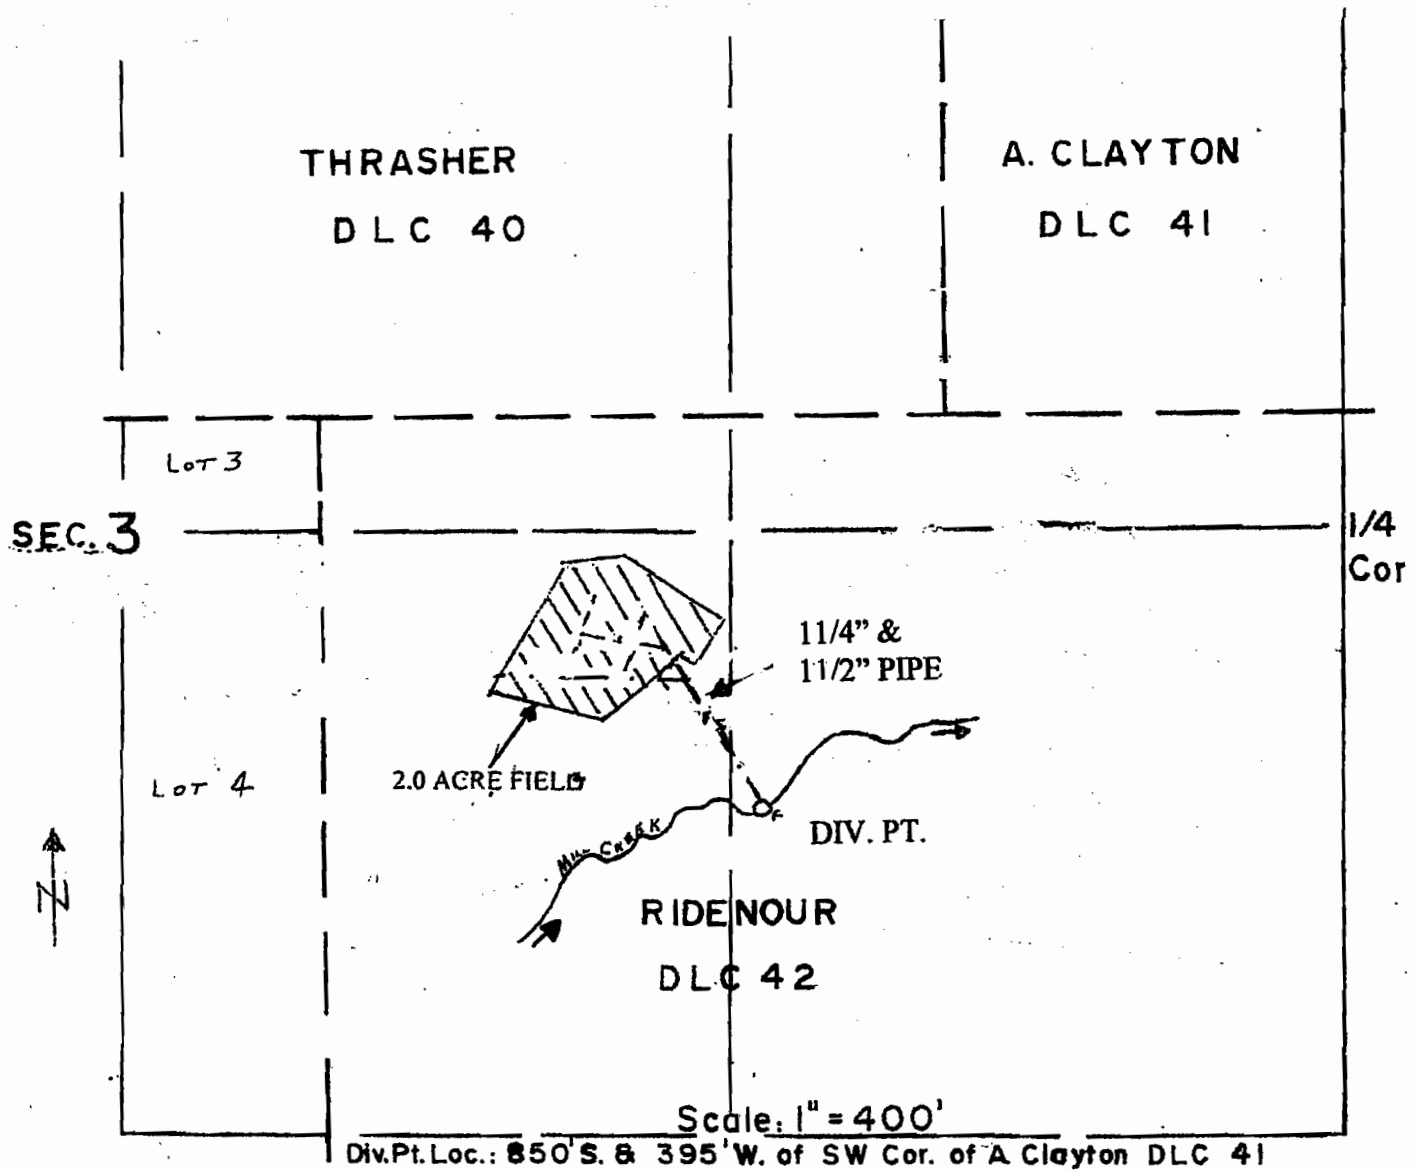

THE PURPOSE OF THIS MAP IS TO
IDENTIFY THE LOCATION OF THE
WATER RIGHT. IT IS NOT INTENDED
TO PROVIDE INFORMATION RELATIVE
TO THE LOCATION OF PROPERTY
OWNERSHIP BOUNDARY LINES.

