RECEIVED
SEP 14 2012
WATER RESOURCES DEPT
SALEM, OREGON

710

T. 4S. R4W., W.M.

KCK FARMS

PORTIONS OF SECTIONS 35 AND 36
T4S R4W, W.M.
YAMHILL COUNTY
11483 AMITY-DAYTON HIGHWAY SE
DAYTON, OREGON 97114

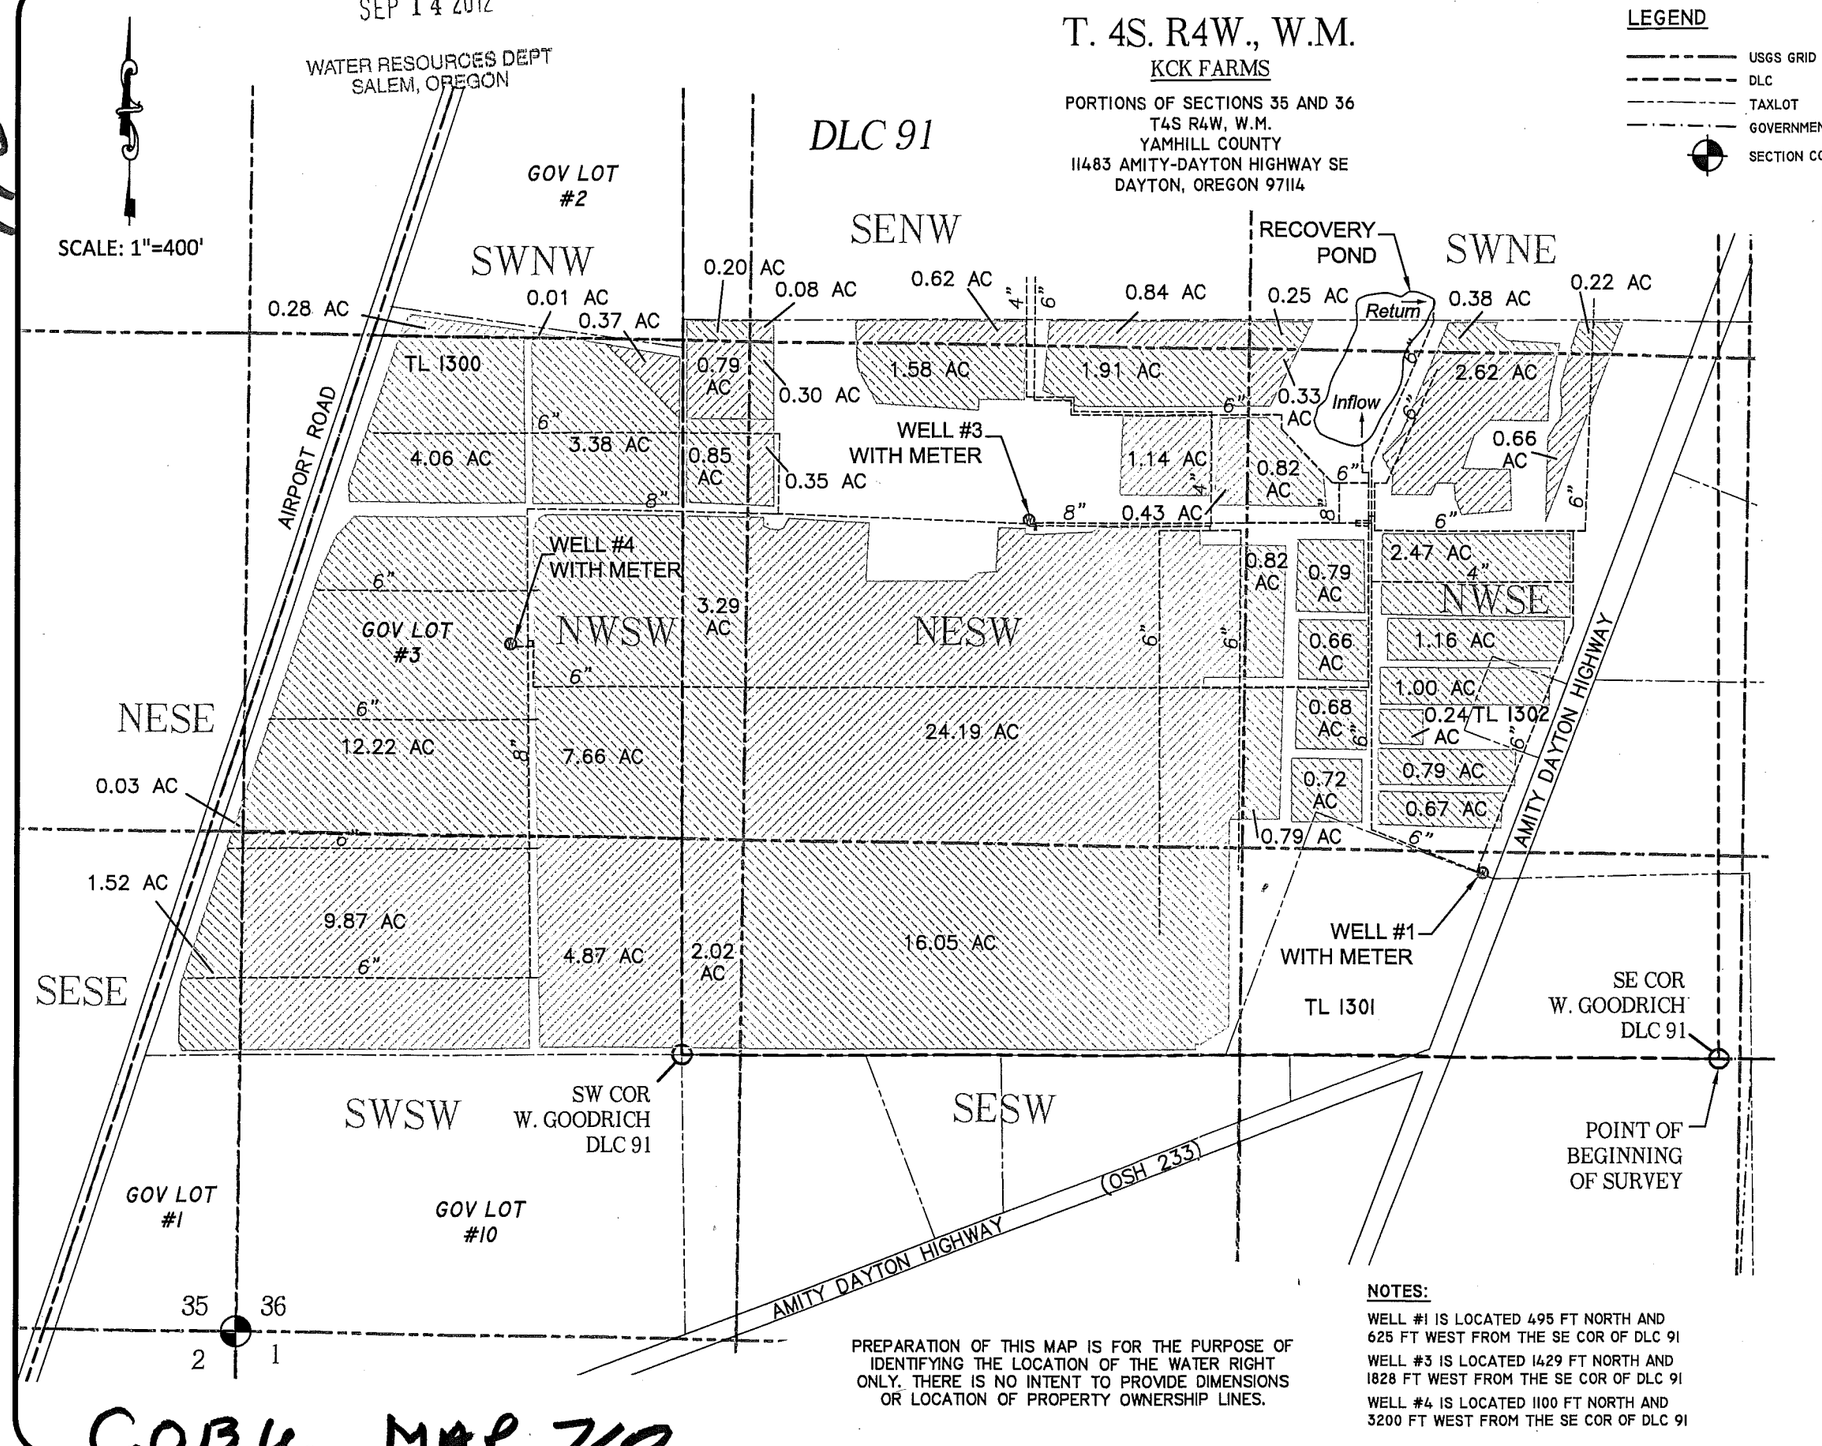

LEGEND

- USGS GRID
- DLC
- TAXLOT
- GOVERNMENT LOT
- SECTION CORNER
- MAIN LINE
- DRIP IRRIGATION HEADER
- SUPPLEMENTAL IRRIGATION
- PRIMARY IRRIGATION

P.O.U. - PLACE OF IRRIGATION USE BY ACRES BY 1/4 1/4

SECTION 35

WITHIN GOV. LOT #1
NE 1/4 SE 1/4 – 0.03 AC (SUPPLEMENTAL)
SE 1/4 SE 1/4 – 1.52 AC (SUPPLEMENTAL)

SECTION 35 TOTAL = 1.54 AC
1.55 AC -

SECTION 36

WITHIN DLC 91
NE 1/4 SW 1/4 – 3.79 AC (PRIMARY)
NE 1/4 SW 1/4 – 26.11 (SUPPLEMENTAL)
NW 1/4 SE 1/4 – 3.61 AC (PRIMARY)
NW 1/4 SE 1/4 – 11.61 AC SUPPLEMENTAL)
NW 1/4 SW 1/4 – 0.79 AC (PRIMARY)
NW 1/4 SW 1/4 – 4.14 AC (SUPPLEMENTAL)
SE 1/4 NW 1/4 – 1.54 AC (PRIMARY)
SE 1/4 SW 1/4 – 16.05 AC (SUPPLEMENTAL)
SW 1/4 NE 1/4 – 0.85 AC (PRIMARY)
SW 1/4 NW 1/4 – 0.20 AC (PRIMARY)
SW 1/4 SW 1/4 – 2.02 AC (SUPPLEMENTAL)

WITHIN GOV. LOT #3
NW 1/4 SW 1/4 – 0.37 AC (PRIMARY)
NW 1/4 SW 1/4 – 27.32 AC (SUPPLEMENTAL)

WITHIN GOV. LOT #2
SW 1/4 NW 1/4 – 0.29 AC (SUPPLEMENTAL)

WITHIN GOV. LOT #10
SW 1/4 SW 1/4 – 14.74 AC (SUPPLEMENTAL)

SECTION 36 TOTAL = 113.43 AC

SURVEY

AND CLAIM OF BENEFICIAL USE UNDER
APPLICATION NO. G-14663, PERMIT NO. G-13597
IN THE NAME OF
KCK FARMS
FOR
IRRIGATION FROM THREE WELLS
IN THE PALMER CREEK BASIN
SURVEYED 9/28/2011 BY JOHN E. BORDEN, CWRE

PREPARATION OF THIS MAP IS FOR THE PURPOSE OF IDENTIFYING THE LOCATION OF THE WATER RIGHT ONLY. THERE IS NO INTENT TO PROVIDE DIMENSIONS OR LOCATION OF PROPERTY OWNERSHIP LINES.

NOTES:

WELL #1 IS LOCATED 495 FT NORTH AND 625 FT WEST FROM THE SE COR OF DLC 91
WELL #3 IS LOCATED 1429 FT NORTH AND 1828 FT WEST FROM THE SE COR OF DLC 91
WELL #4 IS LOCATED 1100 FT NORTH AND 3200 FT WEST FROM THE SE COR OF DLC 91

Certified Water Right Examiner
#302 WRE
John E. Borden
May 11, 1994
STATE OF OREGON

COBU MAP 710

Exp: 12/31/2013

KCK Farms Water Right

FILE PATH & NAME: x:\KCK FARMS\G-14663_O-13597_05012

5597 RIVER STREET
WEST LINN, OR. 97068
503-723-4257

JOHN BORDEN CONSULTING