


T.37S.,R.3E.,W.M.

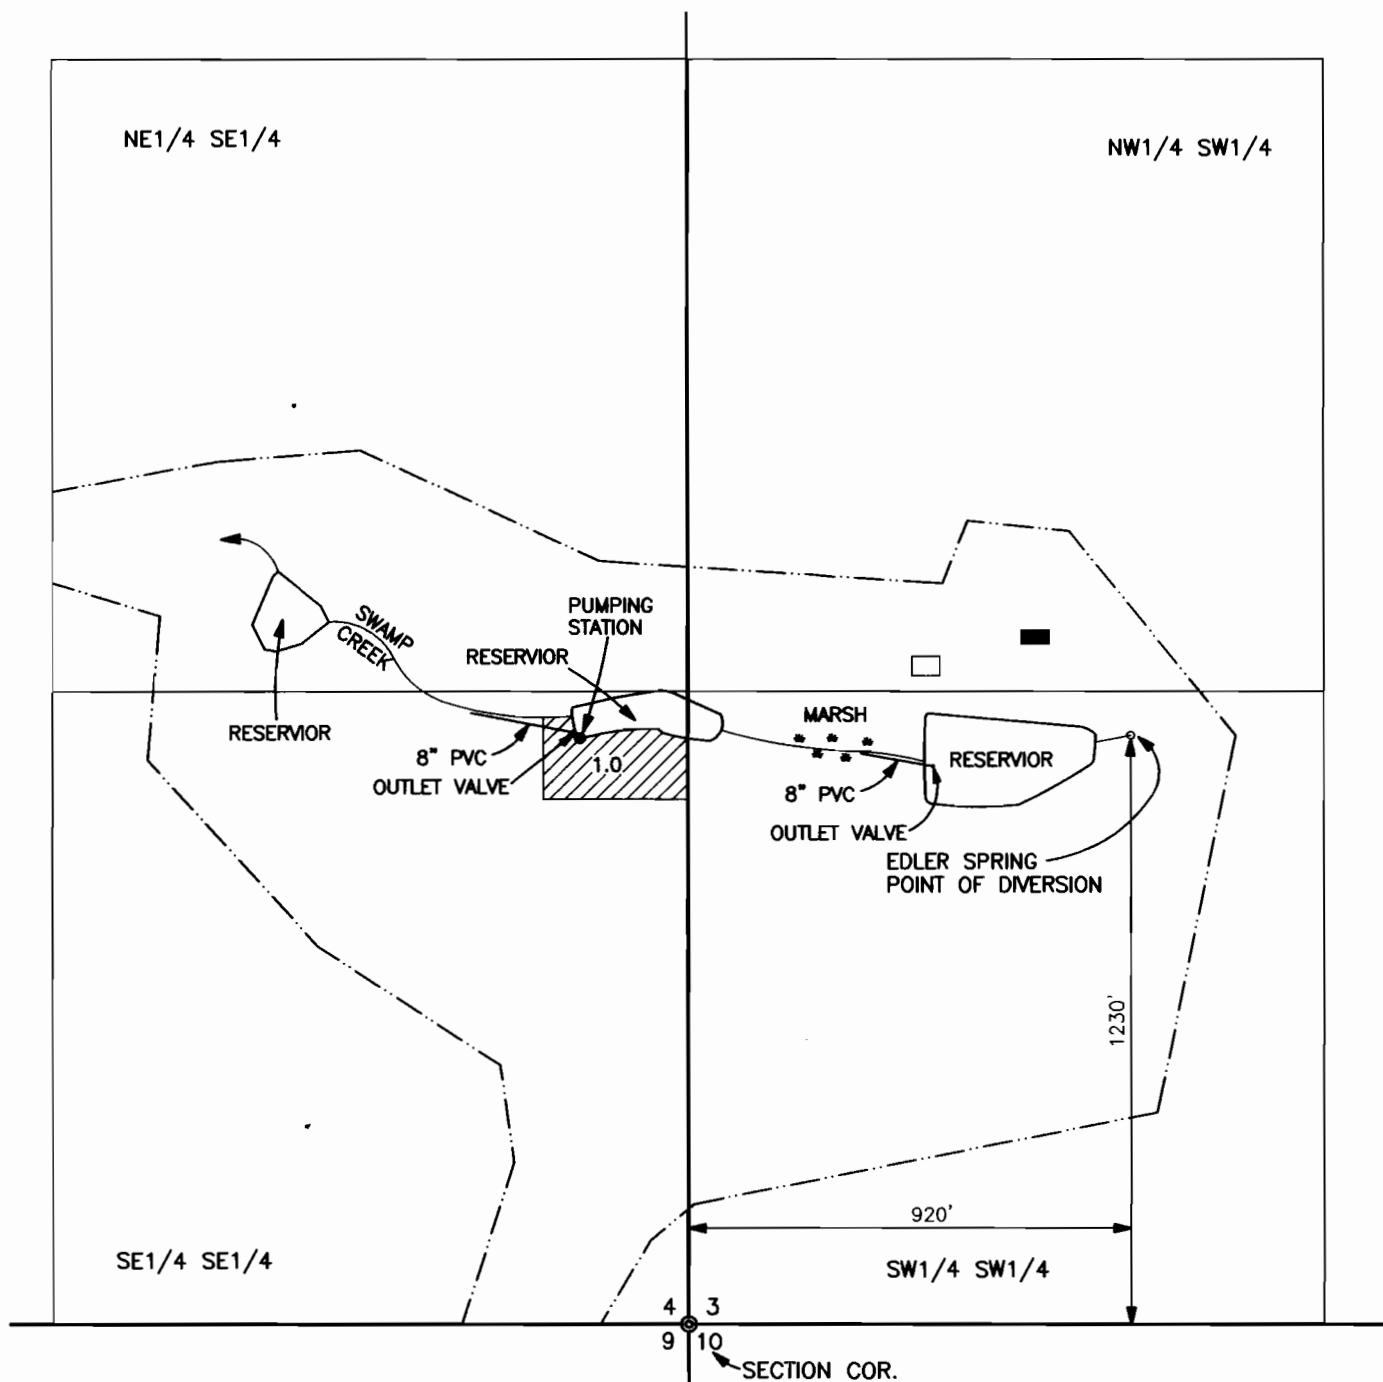


CLAIM OF BENEFITIAL USE MAP

APPLICATION No. T-7209

IN THE NAME OF
CHARLES G. WILSON

NOTE: MAP PREPARED FOR
WATER RIGHT PURPOSES ONLY,
NOT FOR PROPERTY BOUNDARY
LOCATIONS.

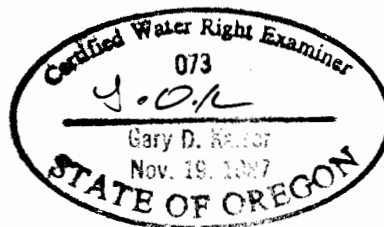

SCALE 1" = 400'

RECEIVED

MAP PREPARED AUGUST 23, 2002 BY GARY D. KAISER

AUG 29 2002
WATER RESOURCES DEPT.
SALEM, OREGON