


RECEIVED

SEP 17 2001


WATER RESOURCES DEPT.
SALEM, OREGON

FINAL PROOF SURVEY MAP T29S, R5W, WM

SCALE 1" = 1320'
DOUGLAS COUNTY

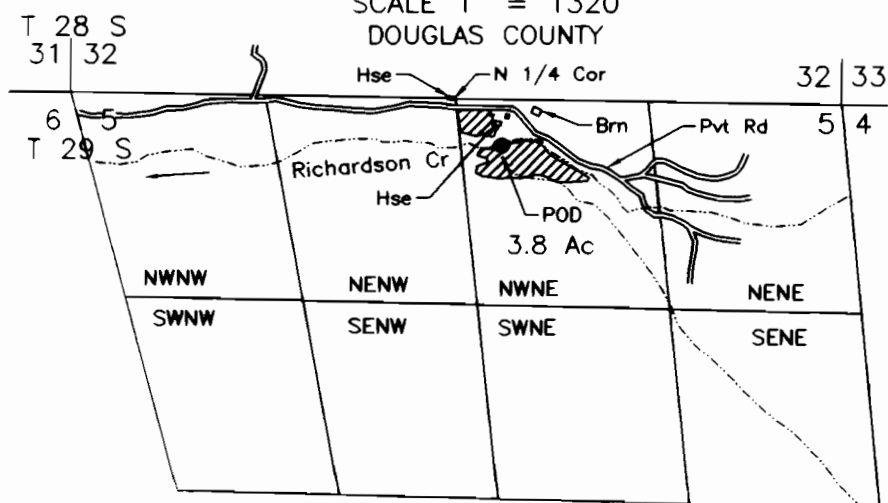

POD IS 330 FT S AND 315 FT E FROM N1/4 COR SEC 5

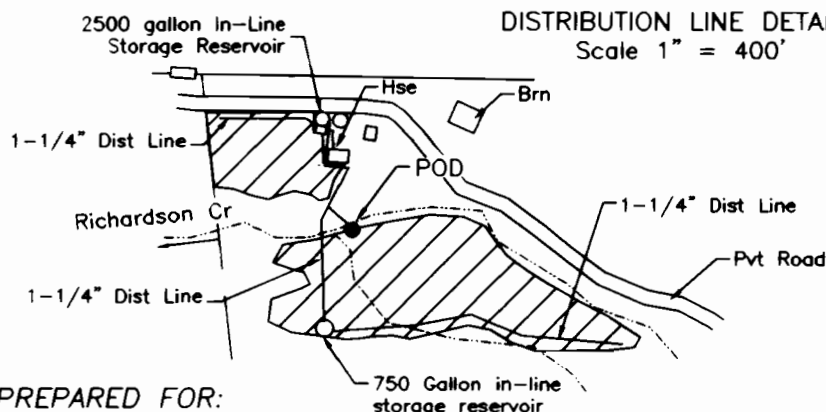

MAP PREPARED FOR:
MICHAEL & RACHEL CONNELLY
DALE MELBA WILLIAMS
JULIA MALLALIEU
1893 RICHARDSON ROAD
MYRTLE CREEK, OR 97457

MAP PREPARED BY:
MAURICE E FARR, CWRE
395 NE KIRBY AVENUE
ROSEBURG, OR 97470

FINAL PROOF SURVEY UNDER

Permit No. 21478 Certificate No. 23601 Transfer No. T 8500

IN NAME OF

Michael & Rachel Connelly; Dale M Williams; Julia Mallalieu

Surveyed May 28, 2001 by M E Farr

THIS IS A LOCATION MAP FOR A WATER RIGHT TRANSFER FINAL PROOF SURVEY BY MICHAEL & RACHEL CONNELLY; DALE M WILLIAMS; AND JULIA MALLALIEU. THIS MAP IS FOR THE PURPOSE OF IDENTIFYING THE LOCATION OF THE WATER RIGHT ONLY AND IS NOT INTENDED TO PROVIDE LEGAL DIMENSIONS OR LOCATIONS OF PROPERTY OWNERSHIP LINES.



EXPIRES 12-31-01