

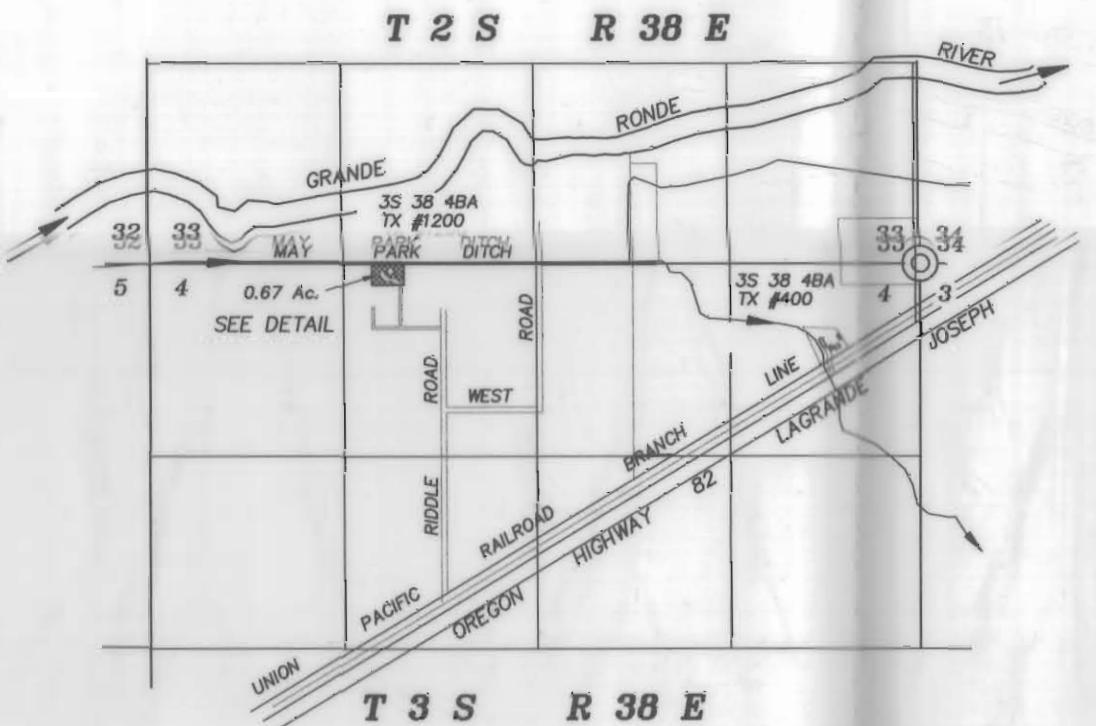


NOT TO SCALE

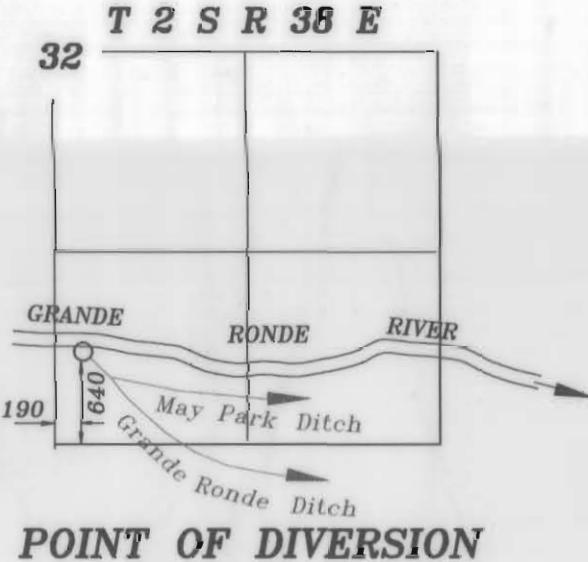


DETAIL FOR BERGESON HOUSE

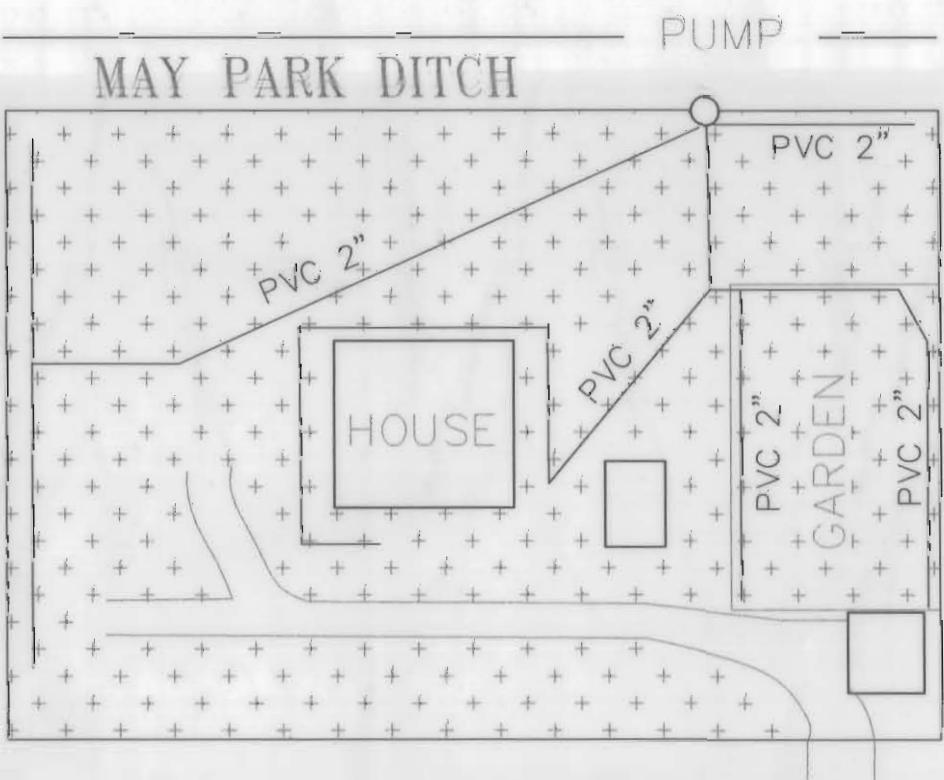

Lands being irrigated from new P.O.D.

SCALE 1" = 1320'

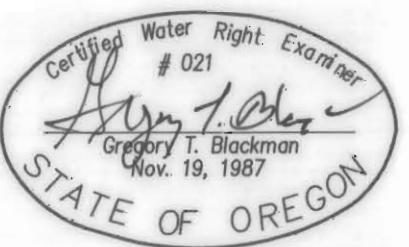

NOTE: The preparation of this map was for the purpose of identifying the location of the proposed water right and has no intent to provide dimensions or location of property ownership lines. Location information shown hereon was furnished by the applicant.

**FINAL PROOF MAP OF
TRANSFER OF PLACE OF USE
AND POINT OF DIVERSION**

FOR

MIKE AND MARILYN BOWEN

BY
BAGETT - GRIFFITH & BLACKMAN
2006 ADAMS AVENUE
LAGRANGE, OREGON 97850

June 15, 2001

APPLICATION NO. **T- 8417**

PERMIT NUMBER **T- 8417**

RECEIVED

JUL 19 2001

WATER RESOURCES DEPT
SALEM, OREGON

RECEIVED

JUL 19 2001

WATER RESOURCES DEPT
SALEM, OREGON