


FINAL PROOF SURVEY MAP IN THE NAME OF FRED A. DAYTON, Jr.

PERMIT 44241

TRANSFER T-9166

SECTION 36, TOWNSHIP 27 SOUTH, RANGE 5 WEST, W.M.

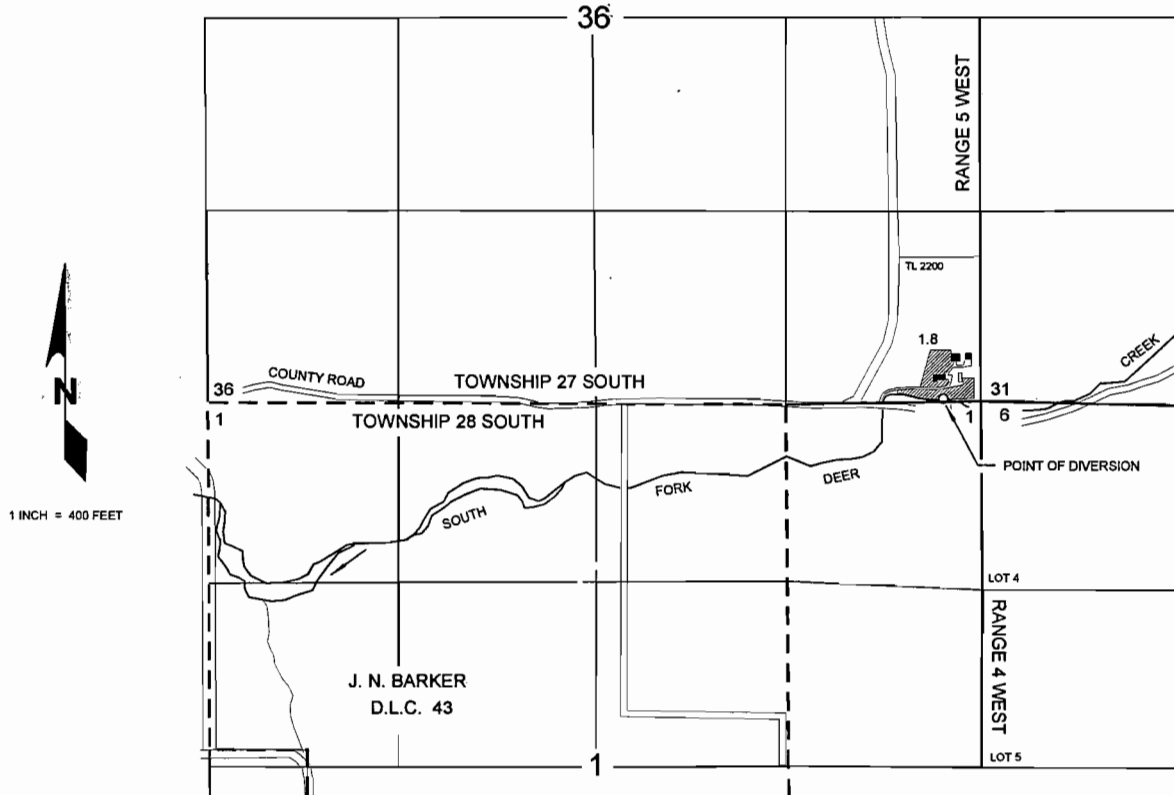

THE POINT OF DIVERSION IS LOCATED 10 FEET NORTH AND 265 FEET EAST FROM THE SOUTHEAST CORNER OF SECTION 36 BEING WITHIN THE SE $\frac{1}{4}$ SE $\frac{1}{4}$ OF SECTION 36; TOWNSHIP 27 SOUTH, RANGE 5 WEST, W.M.; DOUGLAS COUNTY.



RECEIVED

JAN 24 2006

WATER RESOURCES DEPT
SALEM, OREGON

THE PURPOSE OF THIS MAP IS TO IDENTIFY THE LOCATION OF THE WATER RIGHT. IT IS NOT INTENDED TO PROVIDE INFORMATION RELATIVE TO THE LOCATION OF PROPERTY OWNERSHIP BOUNDARY LINES.