


CLAIM OF BENEFICIAL USE  
 FOR  
 JOHN H. GATES  
 SUZANNE R. GATES  
 T26S, R6WW.M.  
 SECTION 22 & 23  
 TAX LOT 1400  
 TRANSFER 8606

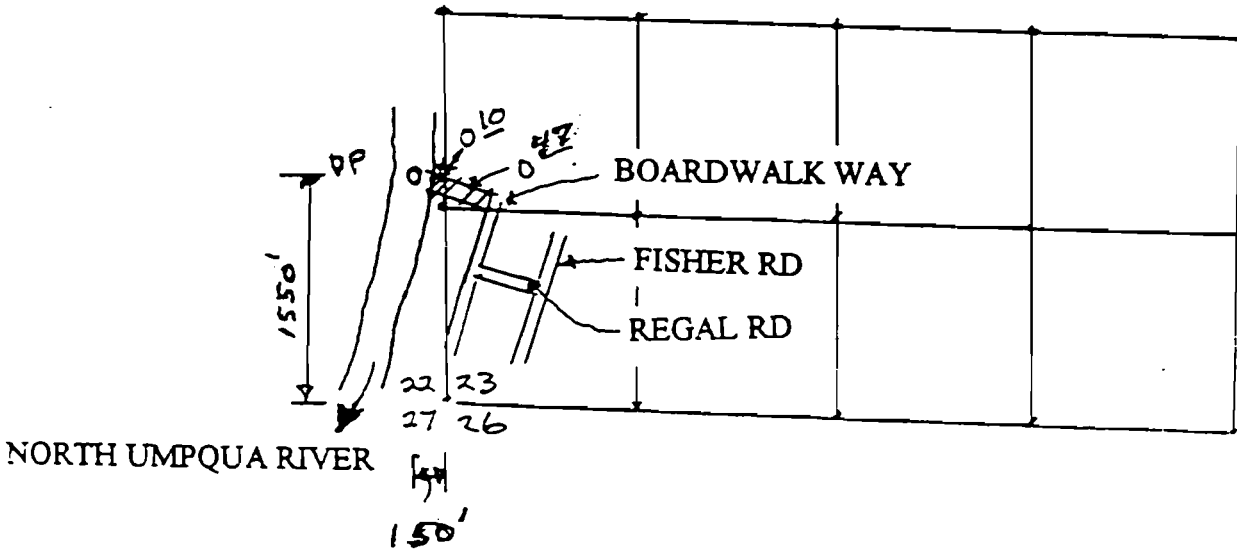

1 INCH = 1320 FEET

T.26S.,R6W.,W.M.



THE PURPOSE OF THIS MAP IS TO IDENTIFY THE LOCATION OF THE WATER RIGHT. IT IS NOT INTENDED TO PROVIDE INFORMATION RELATIVE TO THE LOCATION OF PROPERTY OWNERSHIP BOUNDARY LINES.

