


S.E.1/4, S.W.1/4 & S.W.1/4, S.E.1/4, SECTION 19, TWP.2 N. RANGE 13 E. W.M.
 WASCO COUNTY, OREGON

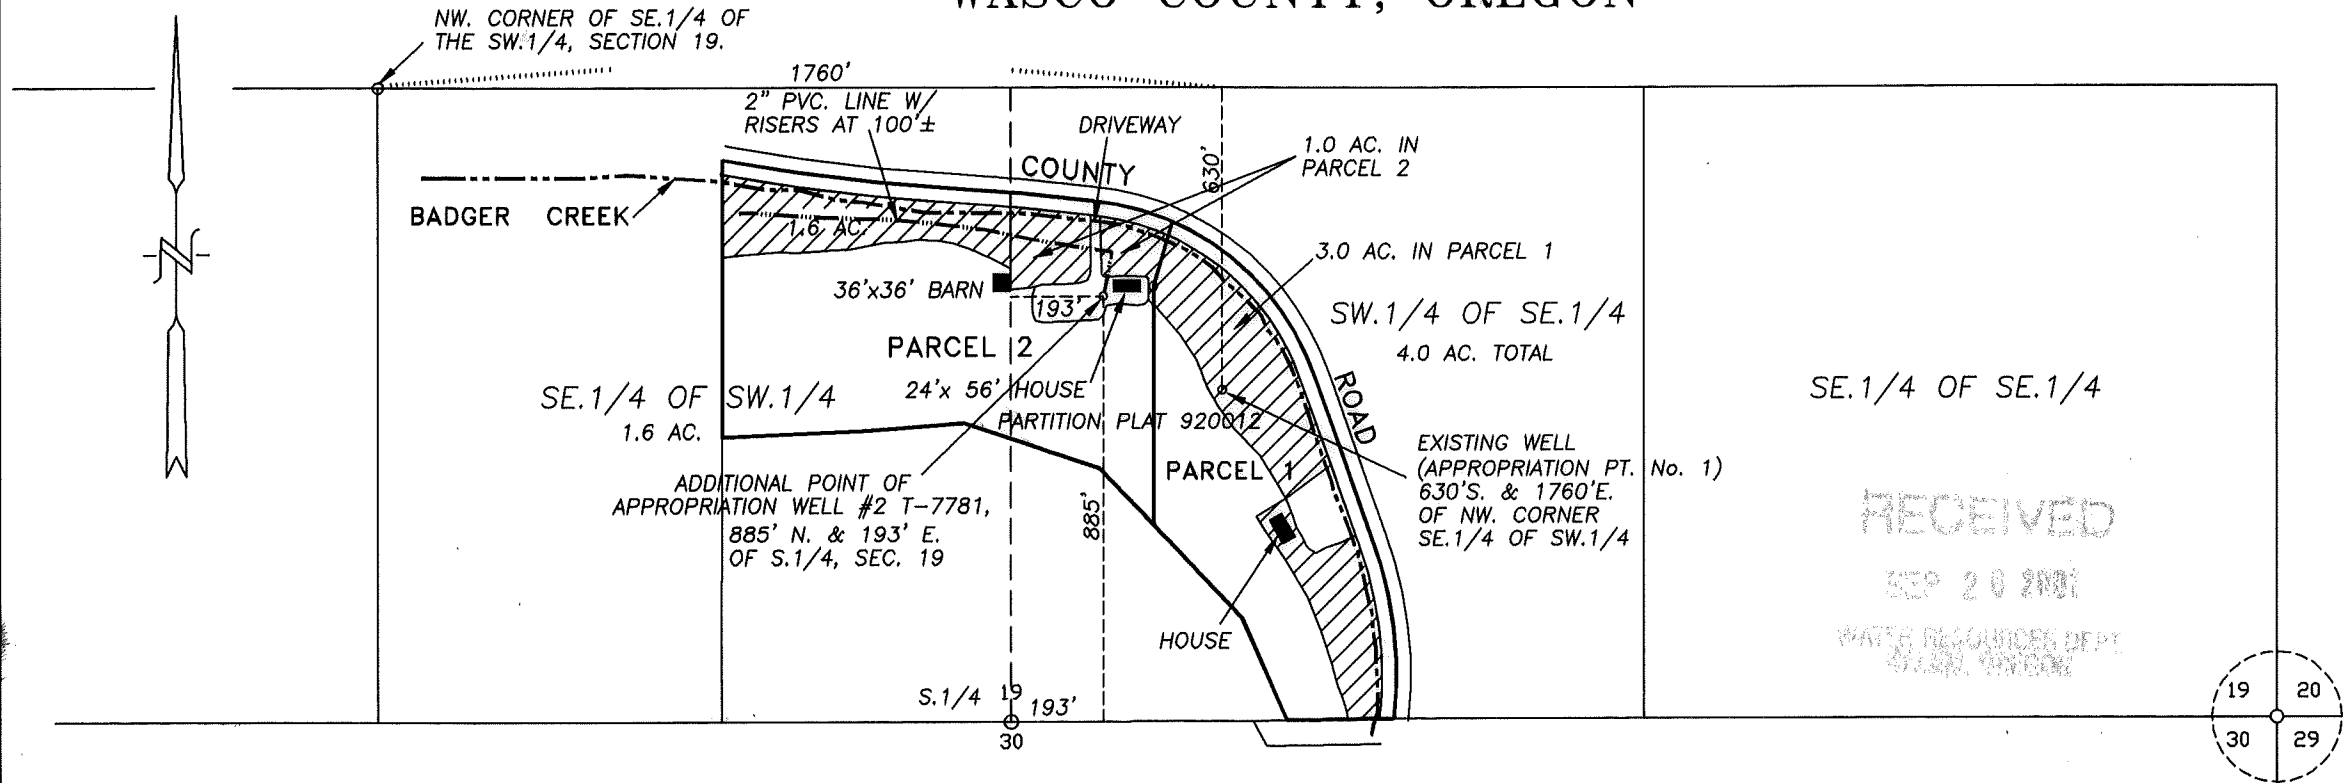

PERMIT No. G-6714

CERTIFICATE No. 54103

TRANSFER No. T-7781

IN THE NAME OF:
STAN PEICKERT

DATE: SEPTEMBER 24, 2001

WATER RIGHT FINAL PROOF SURVEY
(TRANSFER & ADDITIONAL APPROPRIATION POINT)

SCALE: 1" = 400'

BY: TENNESON ENGINEERING CORP.
 409 LINCOLN STREET,
 THE DALLES, OREGON. 97058
 PH. 541-296-9177
 FAX 541-296-6657

NOTE:

"THIS MAP IDENTIFIES THE LOCATION OF THE WATER RIGHT ONLY AND IS NOT INTENDED TO PROVIDE DIMENSIONS OR LOCATE PROPERTY OWNERSHIP LINES."

