


CLAIM OF BENEFICIAL USE SURVEY FOR T-7940

T.34S.,R.2W.,Sec.19 W.M.

Jackson County

May 28, 2002

Handwritten signature and notes

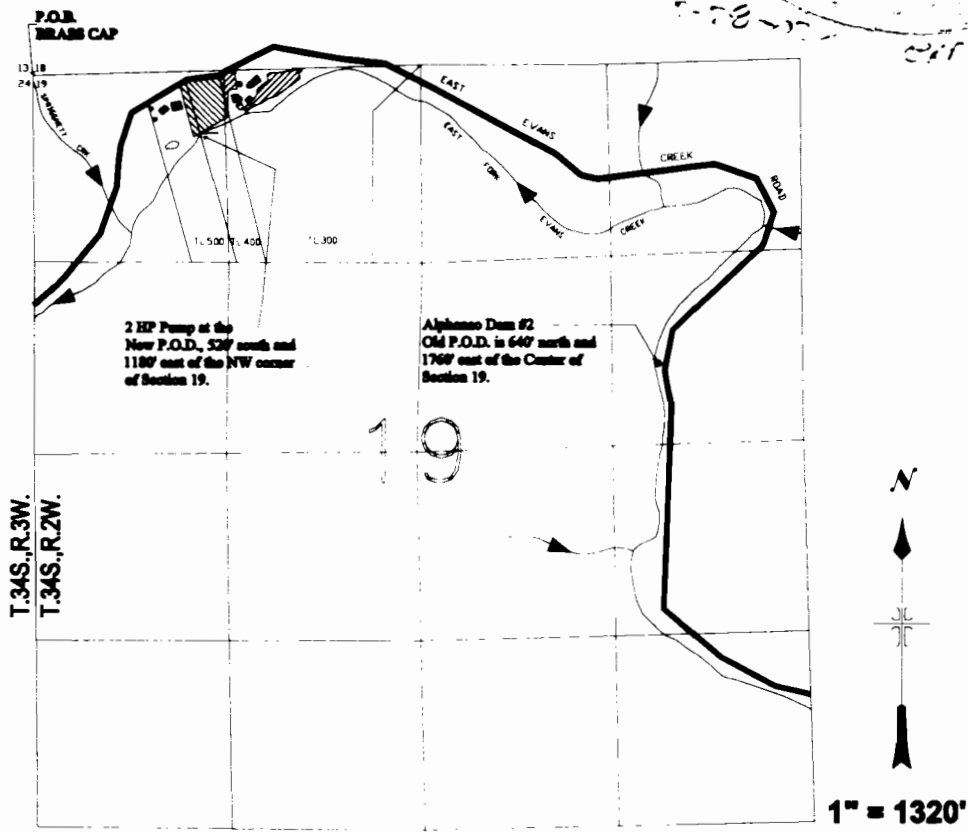

Perfected T-7940 rights with a 1892 priority from East Fork Evans Creek.
0.1 acres in the NE1/4NW1/4, and 1.9 acres in the NW1/4NW1/4 of Section 19.

Perfected T-8031 rights with a 1892 priority from East Fork Evans Creek.
0.1 acres in the NW1/4NW1/4, and 1.4 acres in the NE1/4NW1/4 of Section 19.

This map was prepared by Gordon R. Lyford for Thomas and Debra Nicksayn who own tax lots 400 and 500. They were granted Transfer Order 7940 on February 10, 1999.

This map was prepared for the purposes of identifying the location of water rights only and is not intended to provide legal dimensions or the location of property ownership lines.