
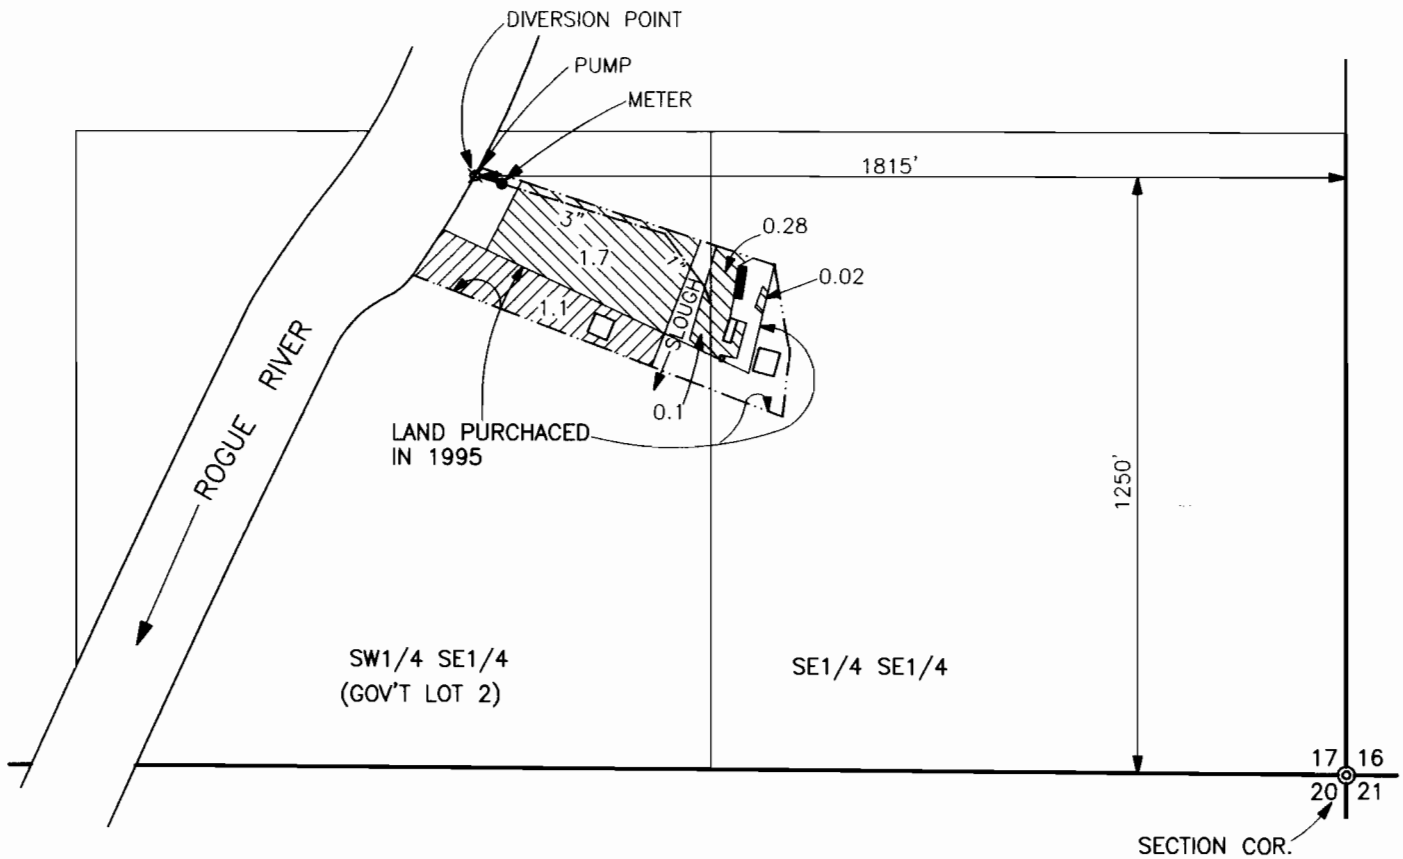
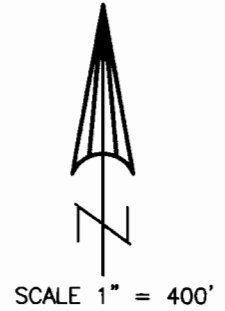



T.35S.,R.1W.,W.M.
 Jackson County, Oregon
 Tax Lot No. 351W 17-1200

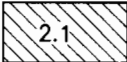

CLAIM OF BENEFICIAL USE
 TRANSFER No. I-6653

IN THE NAME OF
ALEX BOUTACOFF

 = IRRIGATED ACREAGE
 T-6653

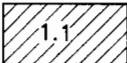 = IRRIGATED ACREAGE ON LAND
 PURCHASED IN 1995
 CERT. 75432 (NOT A PART
 OF THIS TRANSFER)

MAP PREPARED SEPTEMBER 26, 2001 BY GARY D. KAISER

NOTE: MAP PREPARED FOR
 WATER RIGHT PURPOSES ONLY,
 NOT FOR PROPERTY BOUNDARY
 LOCATIONS.

RECEIVED

OCT 01 2001

WATER RESOURCES DEPT.
 SALEM, OREGON

