


T6N, R35E, S24, WM  
W1/2 of SE 1/4  
Umatilla County

400 200 0 400 Feet

The purpose of this map is to identify the location of a water right. It is not intended to provide information regarding the location of property ownership boundary lines.

JUL 03 2008

FOUNTAINHEAD  
1860 Blue Creek Road  
Walla Walla, WA 99362  
509.529.2646 phone

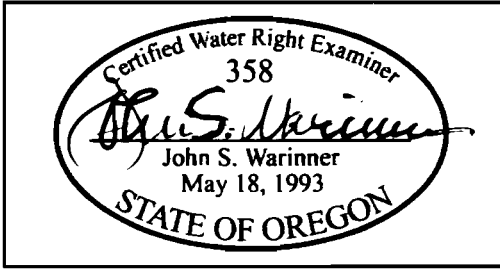

**CLAIM OF BENEFICIAL USE MAP**  
**Transfer 8433**  
  
in the name of  
**LENARD WITTLAKE**  
  
Revised 18 JUN 2008

⊙ **Authorized POA**  
Well is located in the SW/4 of SE/4, Section 24, T6N, R35E, WM, at a distance 1290 feet N and 165 feet E from S/4 Corner of Section 24. No well log available for well. No flowmeter existing nor required.

----- **Conveyance**  
Buried mainline (2.5-inch) distributes water from well throughout authorized place of use. Water applied with impact sprinklers mounted on aluminum handline.

**Authorized POU**  
\* Water beneficially used for irrigation of 3.27 acres in NW/4 of SE/4, Section 24, T6N, R35E, WM.