
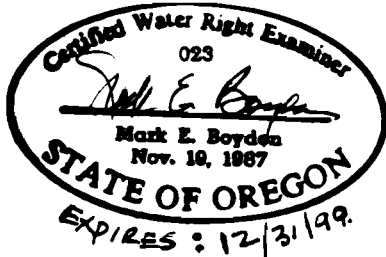


T. 39 S., R. 1 E., W. M.
 (TRANSFER POINT OF DIVERSION)

RECEIVED

SEP 20 1999

WATER RESOURCES DEPT
 SALEM, OREGON

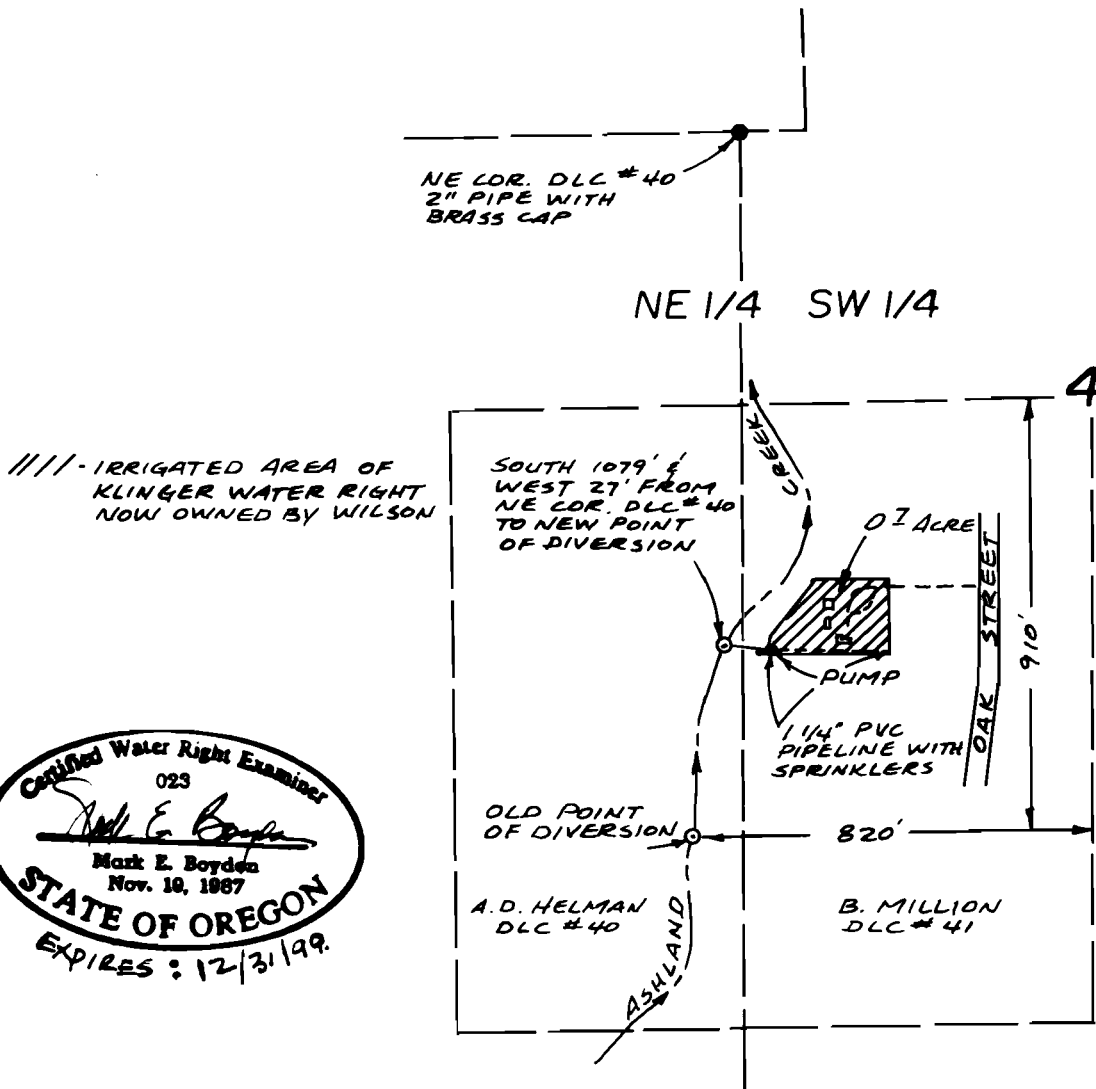

TRANSFER APPLICATION MAP

CERTIFICATE NO. T-7745

APPLICANT: DANIEL WILSON
 777 OAK ST.
 ASHLAND, OR. 97520



SCALE: 1" = 400'

NOTE: THIS MAP IS NOT TO BE UTILIZED FOR BOUNDARY SURVEYS