


NE 1/4, NW 1/4, SW 1/4 & SE 1/4 of the
SECTION 30, T2S, R5E of the W
CLACKAMAS COUNTY, OREGON

RECEIVED

AUG 31 2006


WATER RESOURCES DEPT
SALEM, OREGON

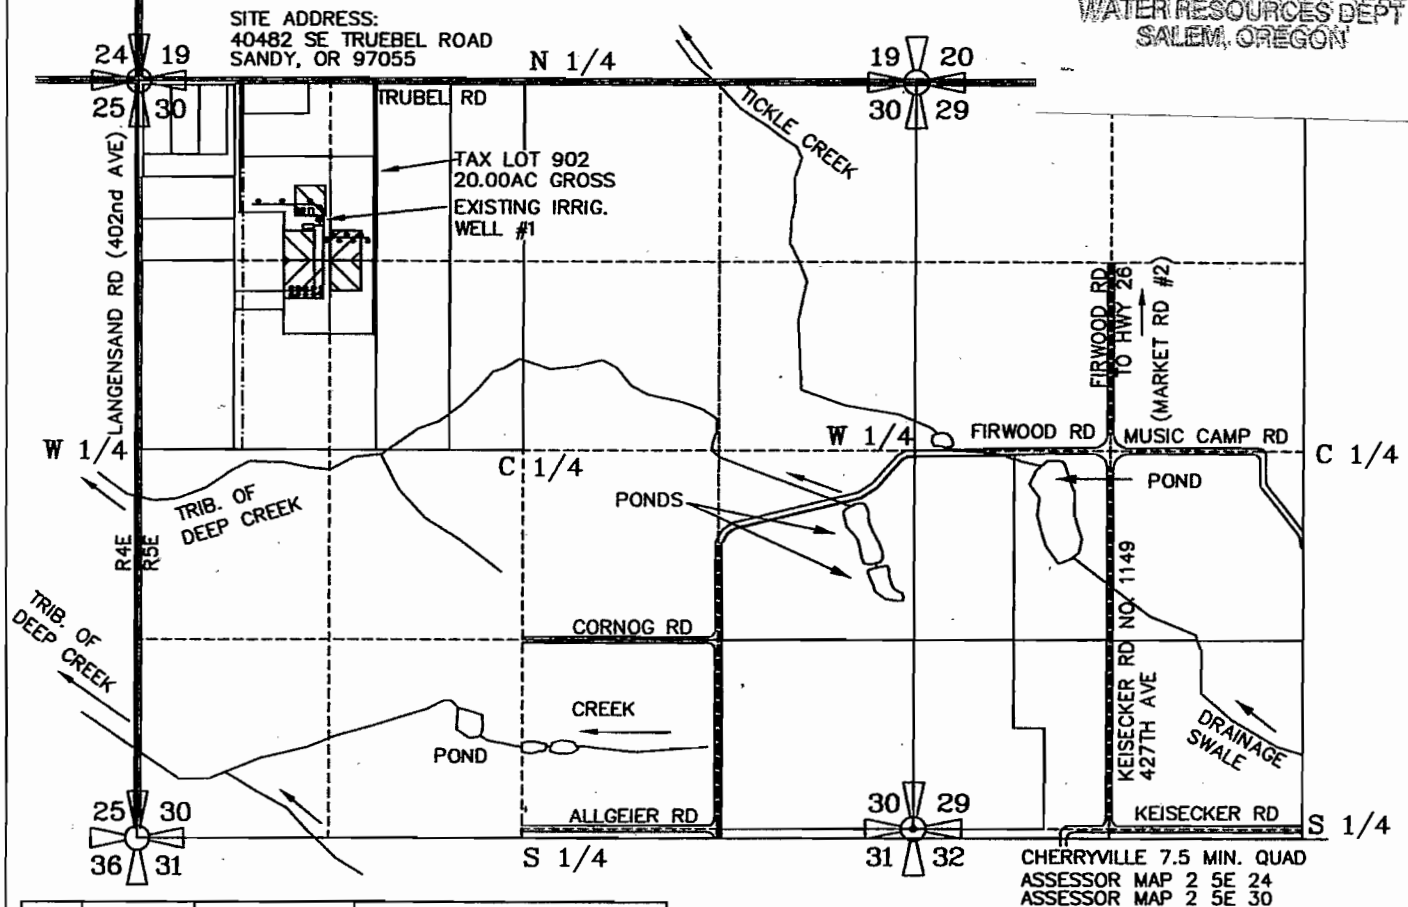

CHERRYVILLE 7.5 MIN. QUAD
ASSESSOR MAP 2 5E 24
ASSESSOR MAP 2 5E 30


SEC.	1/4 1/4	IRRIG. ACRES	CFS (APPROX. GPM)
30	NE NW	1.00 ACRES	0.0125 CFS (5.6 GPM)
30	NW NW	1.00 ACRES	0.0125 CFS (5.6 GPM)
30	SW NW	1.50 ACRES	0.0125 CFS (5.6 GPM)
30	SE NW	1.00 ACRES	0.0125 CFS (5.6 GPM)
TOTAL		4.50 ACRES	0.05 CFS (22GPM)

WELL #1 is located 965 FEET SOUTH and 1240 FEET EAST of the NORTHWEST CORNER of SECTION 30, TOWNSHIP 2 SOUTH, RANGE 5 EAST of the WM, CLACKAMAS COUNTY, OREGON. (The WELL is located in the NORTHWEST QUARTER of the NORTHWEST QUARTER of SECTION 30, T2S, R5E of the WM, CLACKAMAS CO., OR).

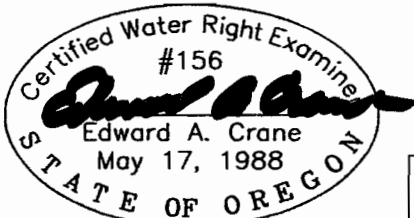

Renewal 12/31/2007
Signed **7/25/06**

SURVEYED JUNE 27, 2006
BY EDWARD A. CRANE, CWRE

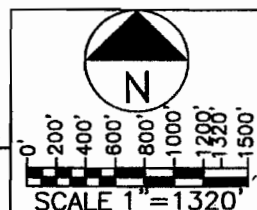

PREPARATION OF THIS MAP WAS FOR THE PURPOSE OF IDENTIFYING THE LOCATION OF THE WATER RIGHTS ONLY AND HAS NO INTENT TO PROVIDE DIMENSIONS OR LOCATION OF PROPERTY OWNERSHIP LINES.

FINAL PROOF SURVEY (SINCLAIR)
GROUNDWATER TRANSFER T-9999

DATE

JULY 2006

PROJECT NO.

523-002



**CRANE ENGINEERING
& SURVEYING, INC.**

13755 SE 119TH DRIVE
CLACKAMAS, OREGON 97015

OFFICE: 503-698-3890
FAX NO: 503-698-3861
CELL: 503-679-3253
E-MAIL: eces@verizon.net

APPLICATION FOR PERMIT NUMBER G-14080
PERMIT NUMBER G-12765 IN THE NAME OF:

BOB SINCLAIR dba SINCLAIR'S ORNAMENTAL
NURSERY, P.O. BOX 951, SANDY, OR 97055
(TEL: 503-936-7113; FAX: 503-775-4432)

SHEET

1/4

ACCESS ROAD
(OWNED)

RECEIVED

AUG 31 2006

WATER RESOURCES DEPT
SALEM, OREGON



TAX LOT 902

DRIP IRRIGATION
IN-GROUND STOCK
EMITTERS 1' CEN-CEN

GREENHOUSE 30'X50'
2-SHADE HOUSES 20'X50'
EXISTING IRRIG.
WELL #1

BARN / SHOP


WELL #1, GARMIN GPS 12
CO-ORDINATES (2-METER ACCURACY)
N: 45°35.540'
W: 122°40.775'

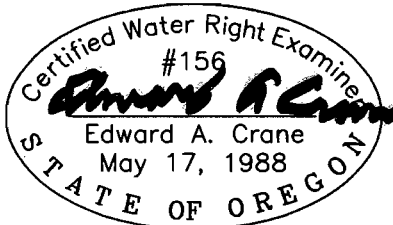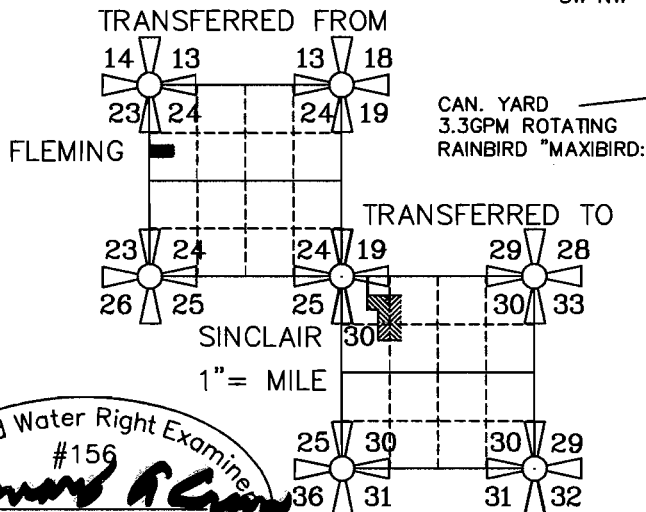

Renewal 12/31/2007

Signed

SURVEYED JUNE 27, 2006
BY EDWARD A. CRANE, CWRE

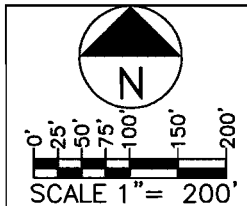

PREPARATION OF THIS MAP WAS FOR THE PURPOSE
OF IDENTIFYING THE LOCATION OF THE WATER RIGHTS
ONLY AND HAS NO INTENT TO PROVIDE DIMENSIONS
OR LOCATION OF PROPERTY OWNERSHIP LINES.

FINAL PROOF SURVEY (SINCLAIR)
GROUNDWATER TRANSFER T-9999

DATE

JULY 2006

PROJECT NO.

523-002



CRANE ENGINEERING
& SURVEYING, INC.

13755 SE 119TH DRIVE
CLACKAMAS, OREGON 97015

OFFICE: 503-698-3890

FAX NO: 503-698-3861

CELL: 503-679-3253

E-MAIL: eces@verizon.net

APPLICATION FOR PERMIT NUMBER G-14080

PERMIT NUMBER G-12765 IN THE NAME OF:

BOB SINCLAIR dba SINCLAIR'S ORNAMENTAL
NURSERY, P.O. BOX 951, SANDY, OR 97055
(TEL: 503-936-7113; FAX: 503-775-4432)

SHEET


2/4

RECEIVED

AUG 31 2006

WATER RESOURCES DEPT
SALEM, OREGON

SW 1/4 of the NW 1/4
SECTION 24
T2S, R4E, WM
CLACKAMAS COUNTY, OREGON

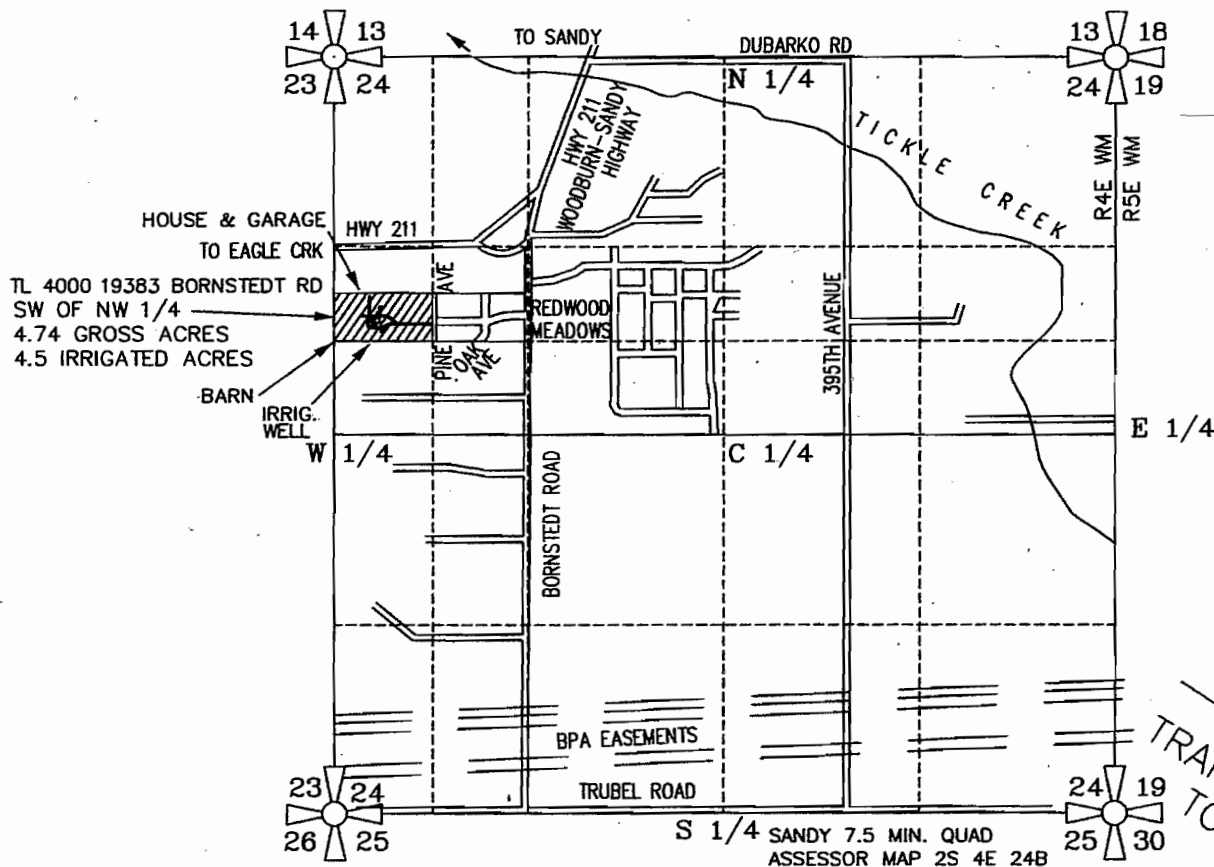

SEC.	1/4 1/4	IRRIG. ACRES	CFS (APPROX. GPM)
24	SW NW	4.50 ACRES	0.050 CFS (22.45 GPM)
TOTAL		4.50 ACRES	0.050 CFS (22.45 GPM)


WELL IS LOCATED 76 FEET NORTH AND 335 FEET EAST OF THE SOUTH-NORTH 1/64 CORNER OF SECTION 24, TOWNSHIP 2 SOUTH, RANGE 4 EAST OF WM, CLACKAMAS COUNTY, OREGON

TRANSFERRED FROM

ORIG. APPL. FOR PERMIT NUMBER G-14080
PERMIT NUMBER G-12765 IN THE NAME OF:
DAVID S. FLOOD 19383 SE BORNSTEDT ROAD
SANDY, OREGON 97255 (TEL: 503-668-9636)
PROPERTY SOLD TO: DAVID & DEBORAH FLEMING
SANDY, OREGON 97255 (TEL: 503-668-9220)

PREPARATION OF THIS MAP WAS FOR THE PURPOSE OF IDENTIFYING THE LOCATION OF THE WATER RIGHTS ONLY AND HAS NO INTENT TO PROVIDE DIMENSIONS OR LOCATION OF PROPERTY OWNERSHIP LINES.


FINAL PROOF SURVEY (FLEMING)
GROUNDWATER TRANSFER T-9999

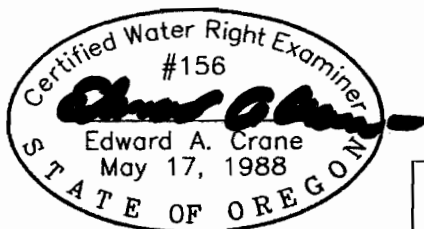

Renewal 12/31/2007

Signed

SURVEYED JULY 27, 2006
BY EDWARD A. CRANE, GWRE

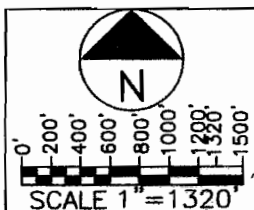

D:\CRANE ENGR & SURVEY\PROJECTS\523-002\CAD\523-002001.DWG 07/24/2006 EAC

DATE JULY 2006		CRANE ENGINEERING & SURVEYING, INC.	APPLICATION FOR PERMIT NUMBER <u>G-14080</u>	SHEET 3/4
PROJECT NO. 523-002		13755 SE 119TH DRIVE CLACKAMAS, OREGON 97015 OFFICE: 503-698-3890 FAX NO: 503-698-3861 CELL: 503-679-3253 E-MAIL: eces@verizon.net	PERMIT NUMBER <u>G-12765</u> IN THE NAME OF: BOB SINCLAIR dba SINCLAIR'S ORNAMENTAL NURSERY, P.O. BOX 951, SANDY, OR 97055 (TEL: 503-936-7113; FAX: 503-775-4432)	

14 13
23 24

SW 1/4 of the NW 1/4
SECTION 24
T2S, R4E, WM
CLACKAMAS COUNTY, OREGON



RECEIVED

AUG 31 2006

WATER RESOURCES DEPT
SALEM, OREGON

WELL IS LOCATED 76 FEET NORTH AND 335 FEET EAST OF
THE SOUTH-NORTH 1/64 CORNER OF SECTION 24, TOWNSHIP 2
SOUTH, RANGE 4 EAST OF WM, CLACKAMAS COUNTY, OREGON


19383 BORNSTEDT RD
TL 4000
SW OF NW 1/4
4.74 GROSS ACRES
4.5 IRRIGATED ACRES

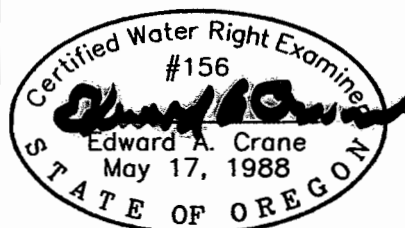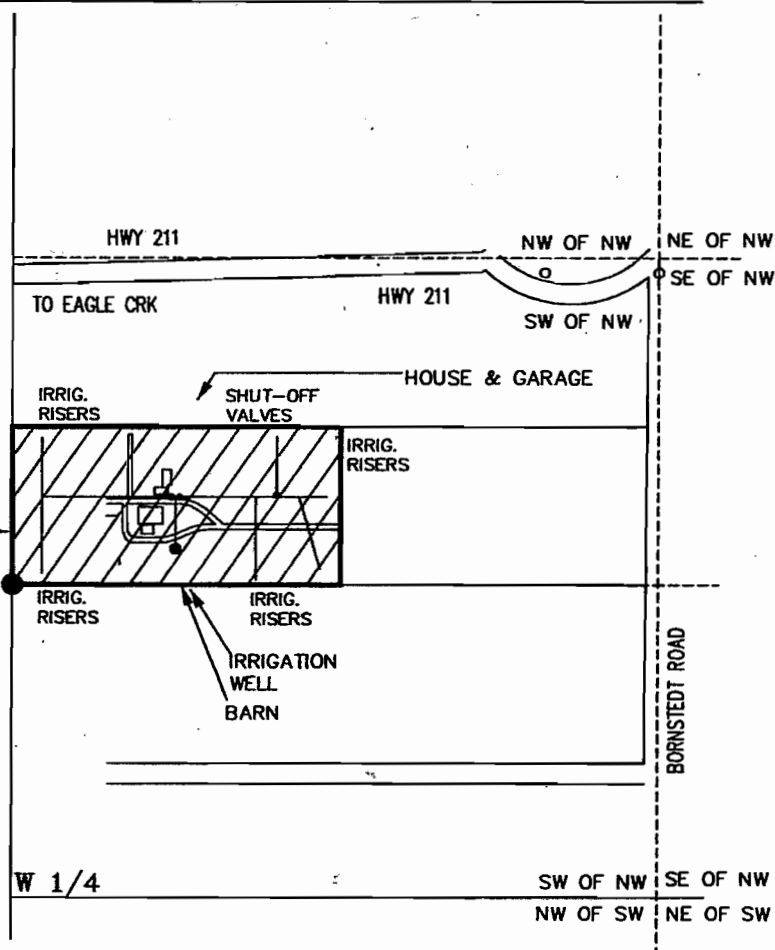

Renewal 12/31/2007
Signed *Edward A. Crane*

SURVEYED JUNE 27, 2006
BY EDWARD A. CRANE, CWRE

D:\CRANE ENGR & SURVEY\PROJECTS\523-002\CAD\523-002001.DWG 07/27/2006 EAC

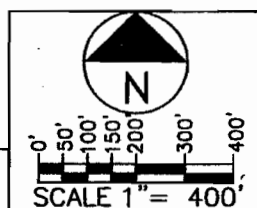

TRANSFERRED FROM

PREPARATION OF THIS MAP WAS FOR THE PURPOSE
OF IDENTIFYING THE LOCATION OF THE WATER RIGHTS
ONLY AND HAS NO INTENT TO PROVIDE DIMENSIONS
OR LOCATION OF PROPERTY OWNERSHIP LINES.

FINAL PROOF SURVEY (FLEMING)
GROUNDWATER TRANSFER T-9999

DATE JULY 2006		& SURVEYING, INC. 13755 SE 119TH DRIVE CLACKAMAS, OREGON 97015 OFFICE: 503-698-3890 FAX NO: 503-698-3861 CELL: 503-679-3253 E-MAIL: eces@verizon.net	APPLICATION FOR PERMIT NUMBER <u>G-14080</u> PERMIT NUMBER <u>G-12765</u> IN THE NAME OF: BOB SINCLAIR dba SINCLAIR'S ORNAMENTAL NURSERY, P.O. BOX 951, SANDY, OR 97055 (TEL: 503-936-7113; FAX: 503-775-4432)	SHEET 4/4
PROJECT NO. 523-002				