


CLAIM OF BENEFICIAL USE MAP (FINAL PROOF SURVEY)

**IN NAME OF:
DERENCE L. KERNEK and
E. EDGAR WATSON**

**SOURCE OF WATER:
DRAPER CREEK AND SPRING CREEK
TRIBUTARIES OF DEER CREEK
TRIBUTARY OF THE ILLINOIS RIVER**

T.38 S. R.08 W. W.M.

NW 1/4, NW 1/4 of SECTION 12

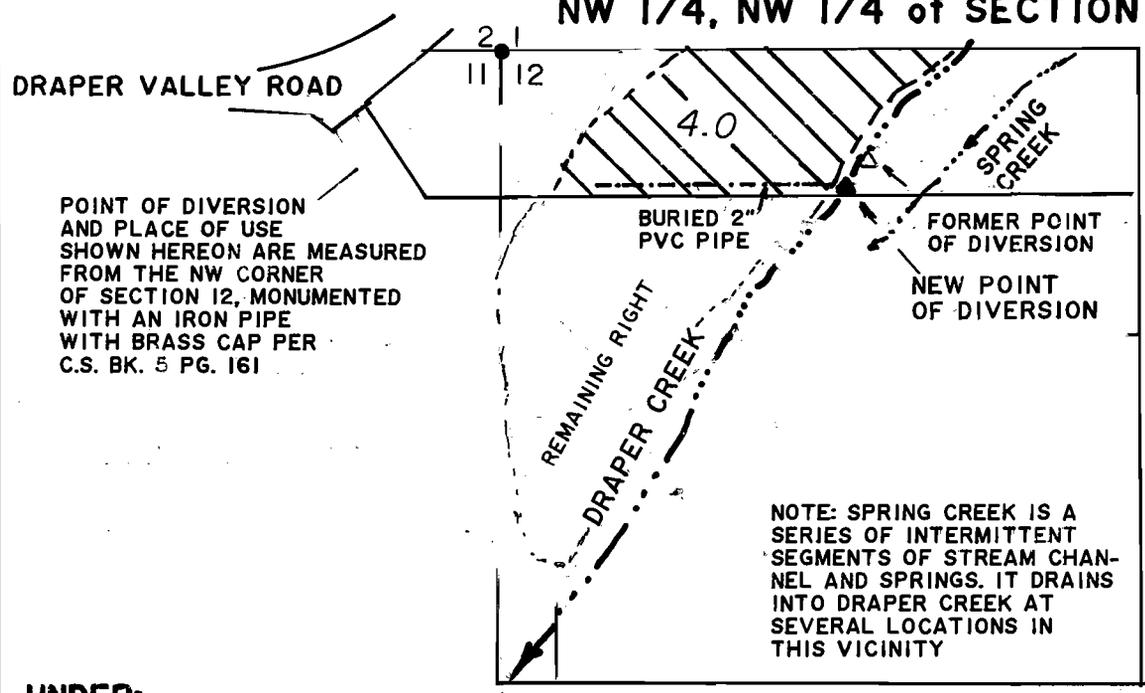


**UNDER:
APPLICATION 7257
PERMIT 4587
CERTIFICATE 4951**

TRANSFER No. 8173

**NEW P.O.D. IS LOCATED:
295 FEET SOUTH & 720 FEET EAST
FROM THE NW CORNER SECTION 12**

**PREPARED BY:
JONATHAN C. SPERO C.W.R.E. 123
1002 KINCAID RD./P.O. BOX 16
WILLIAMS, OREGON 97544
PH. (541) 846-6845**

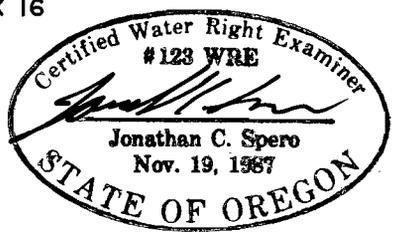

**DATE OF SURVEY:
MAY 22, 2002**

**SURVEYOR'S REGISTRATION LICENSE
RENEWAL DATE: JUNE 30, 2004**

**RECEIVED
FEB 10 2003**

**WATER RESOURCES DEPT.
STATE OF OREGON**

**THIS MAP IS FOR THE PURPOSE OF
IDENTIFYING THE LOCATION OF THE
WATER RIGHT ONLY, AND IS NOT IN-
TENDED TO PROVIDE LEGAL DIMEN-
SIONS OR LOCATIONS OF PROPERTY
OWNERSHIP LINES.**