

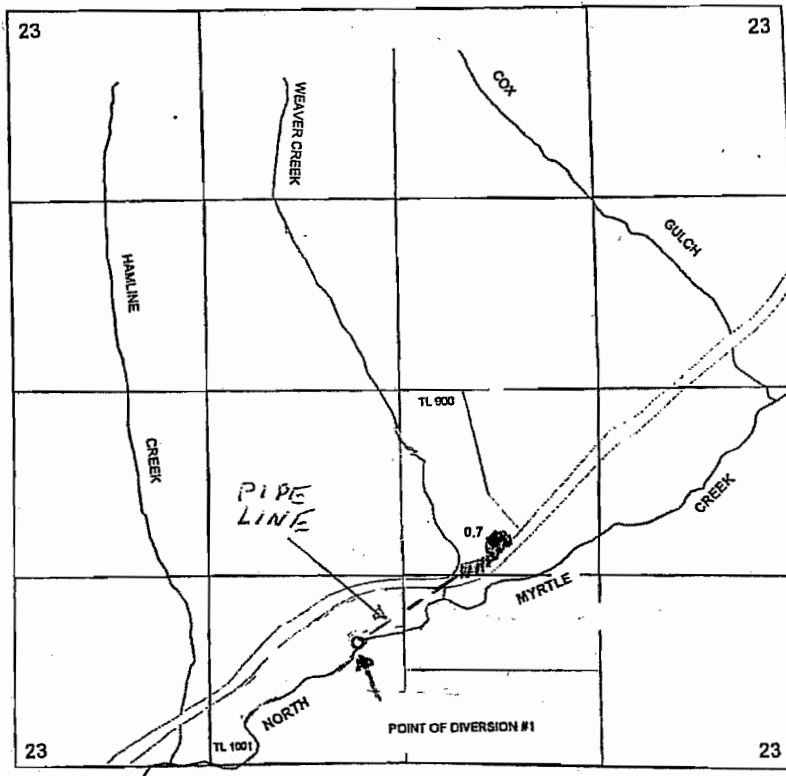


CLAIM OF BENEFICIAL USE
 FOR: RUPERT ARCHULETA
 HELEN ARCHULETA
 BY: DUANE W. KIRBY
 DATE: SEPTEMBER 12, 2006
 T28S, R4W, W.M.
 SECTION 23
 APPLICATION T-9391
 SCALE: 1" = 1320'

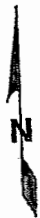

POD NO 1 840'N AND 310' W
 FROM THE S¼ CORNER, SECTION 23

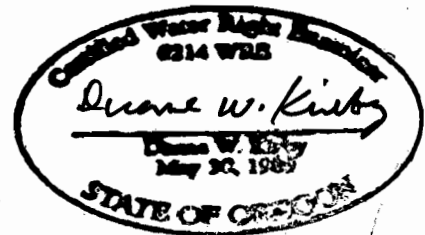

THE PURPOSE OF THIS MAP IS TO IDENTIFY THE LOCATION OF THE WATER RIGHT. IT IS NOT INTENDED TO PROVIDE INFORMATION RELATIVE TO THE LOCATION OF PROPERTY OWNERSHIP BOUNDARY LINES.

