
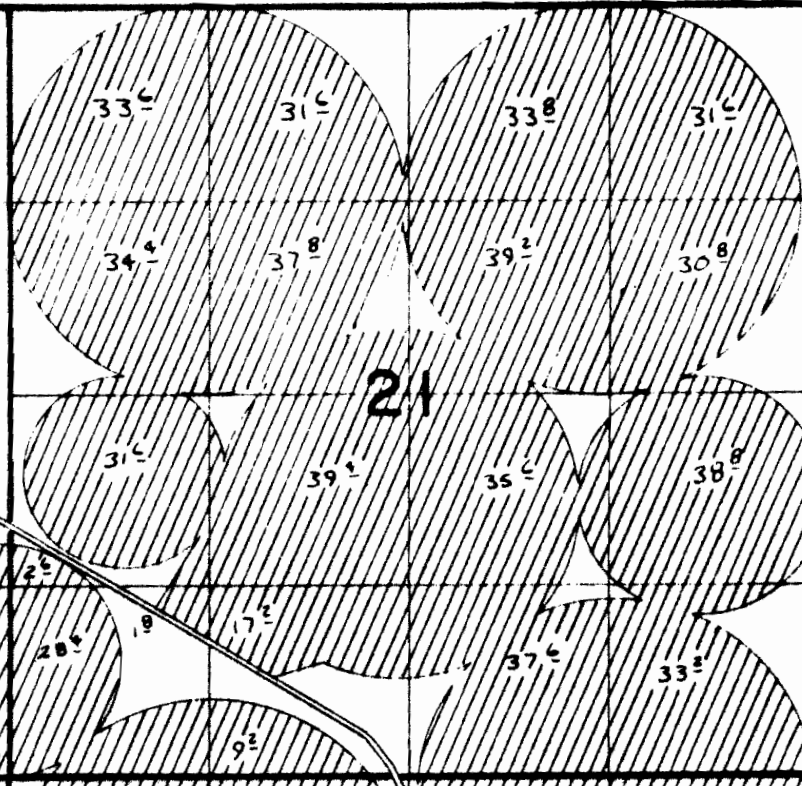


T. 5N., R. 30E., W.M.

To Tom J.

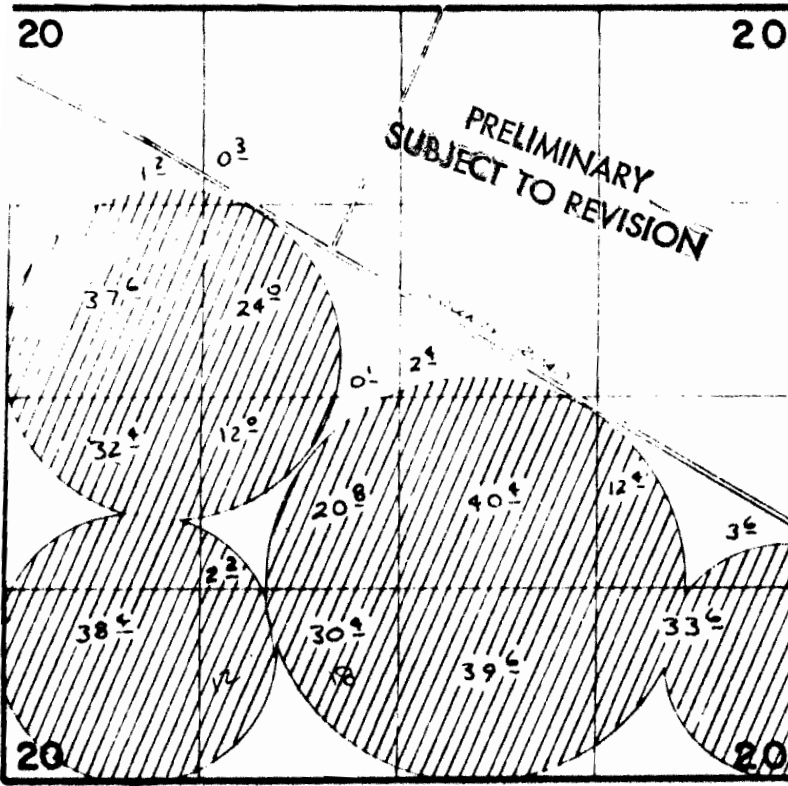

T. 5N. R. 30E. W.M.


PRELIMINARY  
SUBJECT TO REVISION

*Columbia River*  
DIV. PT.

2920'  
150'

PRELIMINARY  
SUBJECT TO REVISION

7 8

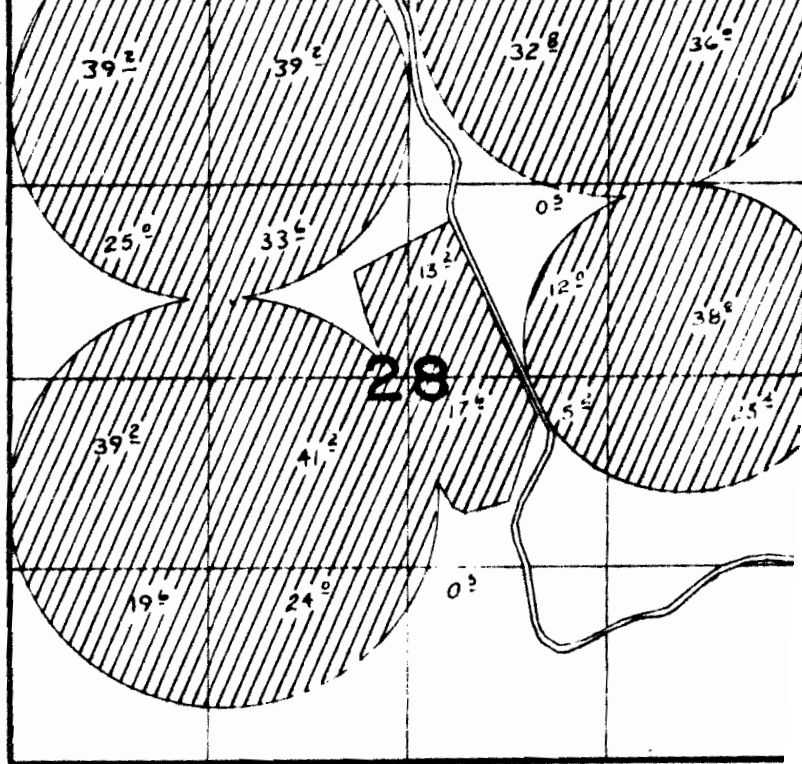

PRELIMINARY  
SUBJECT TO REVISION

PRELIMINARY  
SUBJECT TO REVISION

PRELIMINARY  
SUBJECT TO REVISION

PRELIMINARY  
SUBJECT TO REVISION

FINAL PROOF SURVEY  
UNDER

APPL. 47423

PER. 35522

IN NAME OF

MUTUAL LIFE INS. CO. OF NEW YORK

SURVEYED 2 16-79 BY R. BARWIN