T. 5N., R. 30E., W.M.

FINAL PROOF SURVEY
UNDER

APPL. 49593 PER. 36418
IN NAME OF

MUTUAL LIFE INSURANCE CO. OF
NEW YORK
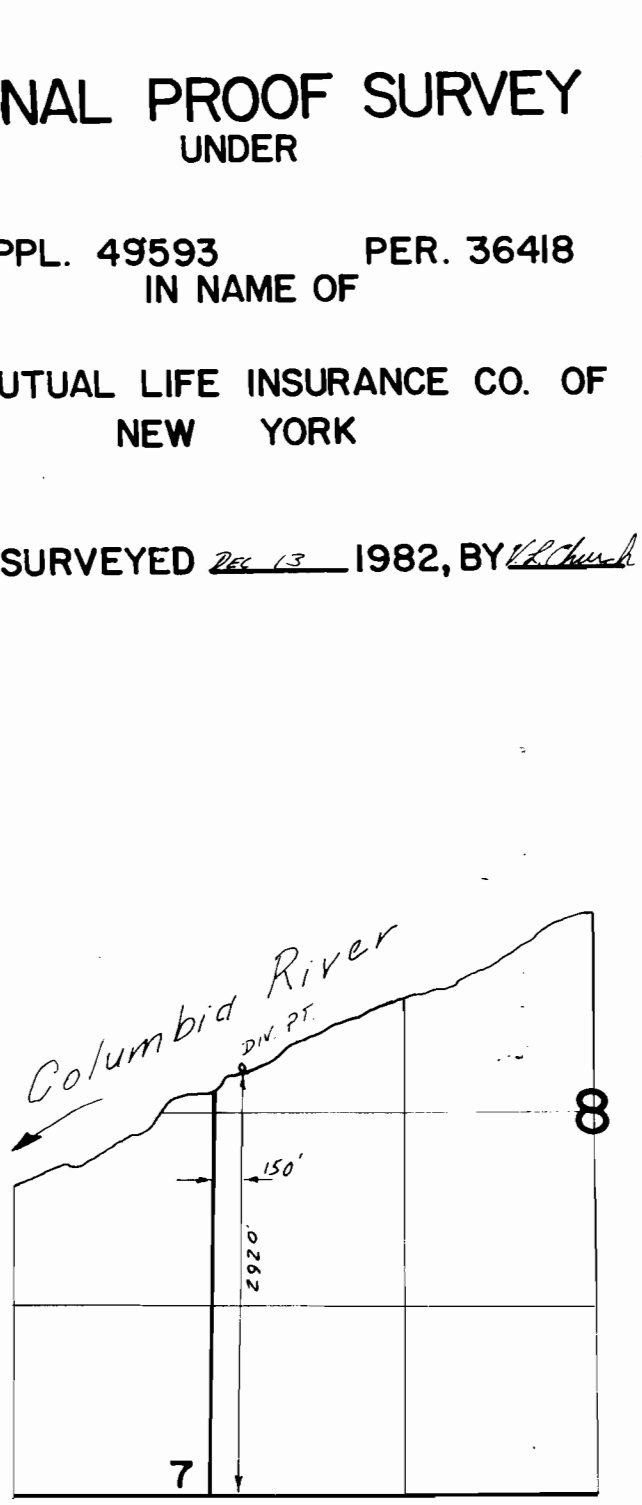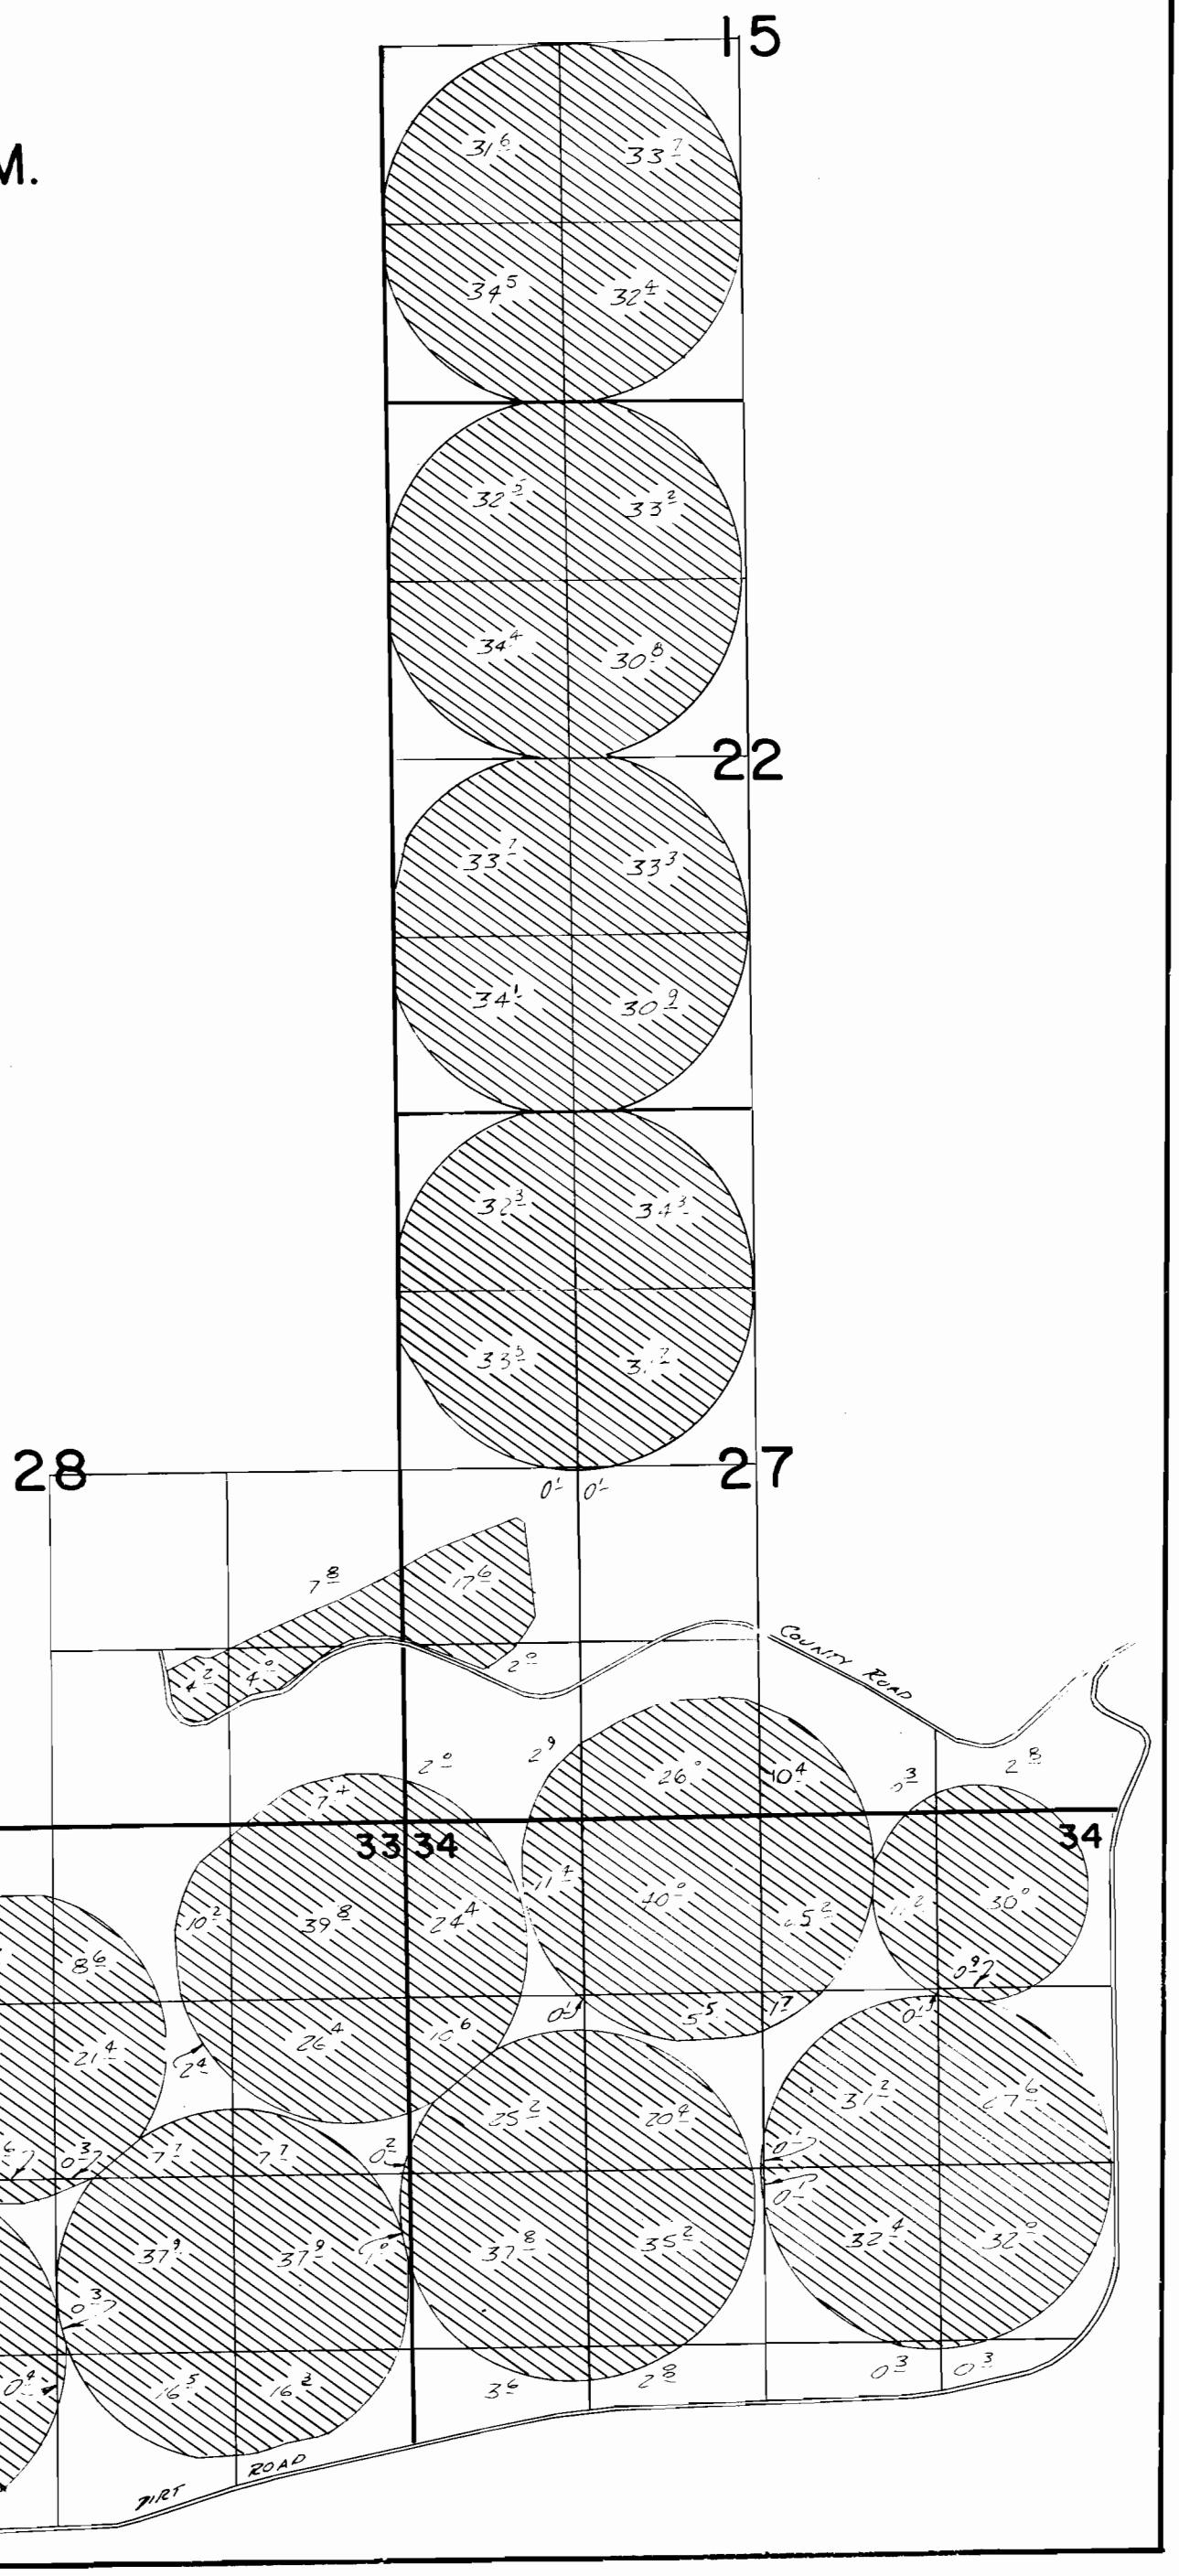
SURVEYED Dec 13 1982, BY V.L. Church