


T11S R26E W.M.

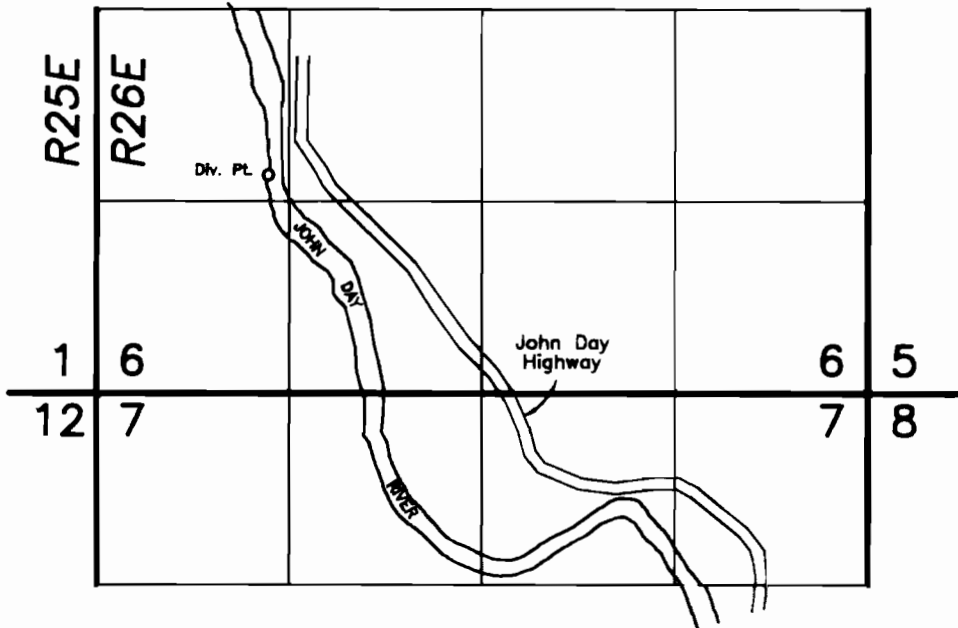

Div. Pt. is 4110' S. and 1590' W. of the S1/4 cor. Sec. 31, T.10S., R.26E.

SCALE 1"=1320'

**FINAL PROOF SURVEY
UNDER**

TRANSFER NO. 7196
SPECIAL ORDER VOL. 51, PG.'S 1245-1247

IN NAME OF
KERRY LANE LOWE

SURVEYED JULY 30, 1999
BY ROBERT D. BAGETT

NOTE: The preparation of this map was for the purpose of identifying the location of the proposed water right and has no intent to provide dimensions or location of property ownership lines. Location information shown hereon was furnished by the applicant.

