


# PROOF OF BENEFICIAL USE MAP FOR T-8670

T. 39 S., R. 8 W., W. M., JOSEPHINE COUNTY

December 10, 2002

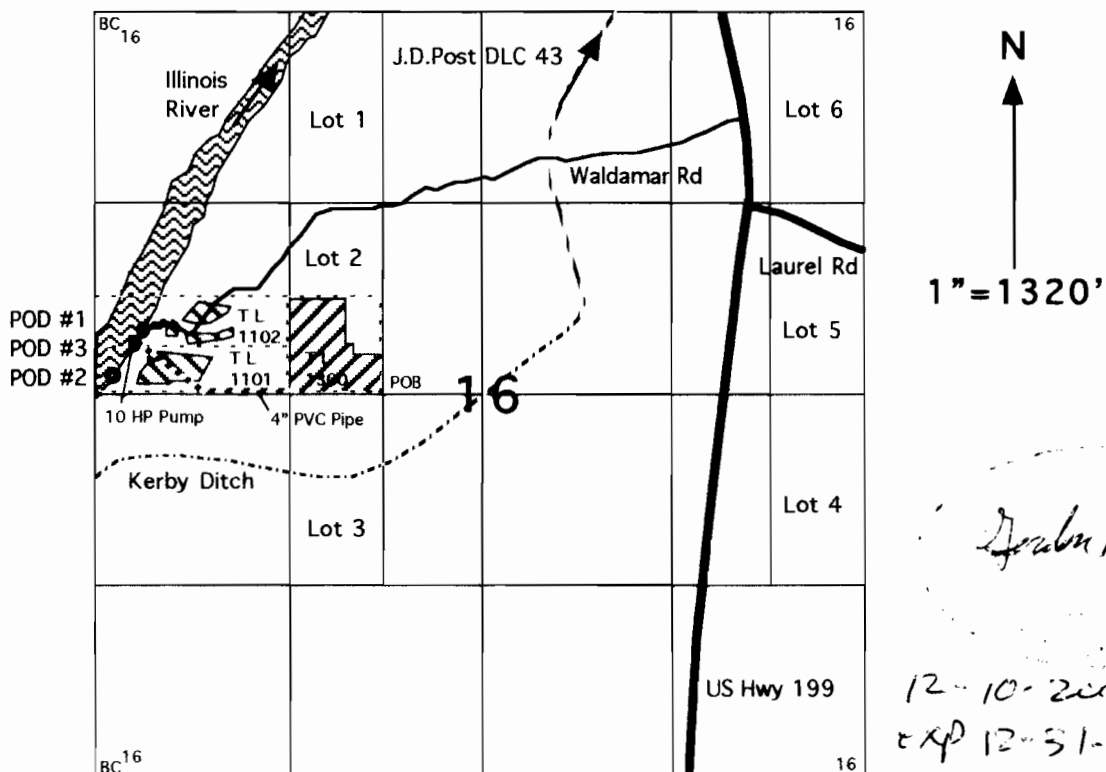

- ☒ 8.0 acres of perfected irrigation water rights in the S1/2 Lot 2 (SE1/4 NW1/4) with a priority of July 27, 1945. Application 21030, Permit 16451, T-8670 from POD #3 located in the SW1/4 NW1/4, Sec 16, 2190' S and 290' E from the NW corner of Section 16, T39S, R8W.
- ☒ 2.9 acres of irrigation water rights in the SW1/4 NW1/4 with a priority of July 24, 1984. Application 68129, Permit 49346, Certificate 67693 from POD #1 and POD #2.

This map was prepared by Gordon R. Lyford for Jon and Jessica Carroll to support their Proof of Beneficial Use under T-8670 which changed the authorized Point of Diversion from the East Fork Illinois River, via the Kerby Ditch, to the Illinois River on their property. Jon and Jessica Carroll own tax lots 1101, 1102, and 1300.

This map was prepared for the purposes of identifying the location of water rights only and is not intended to provide legal dimensions or the location of property ownership lines.