


T.36S.,R.3E.,W.M.

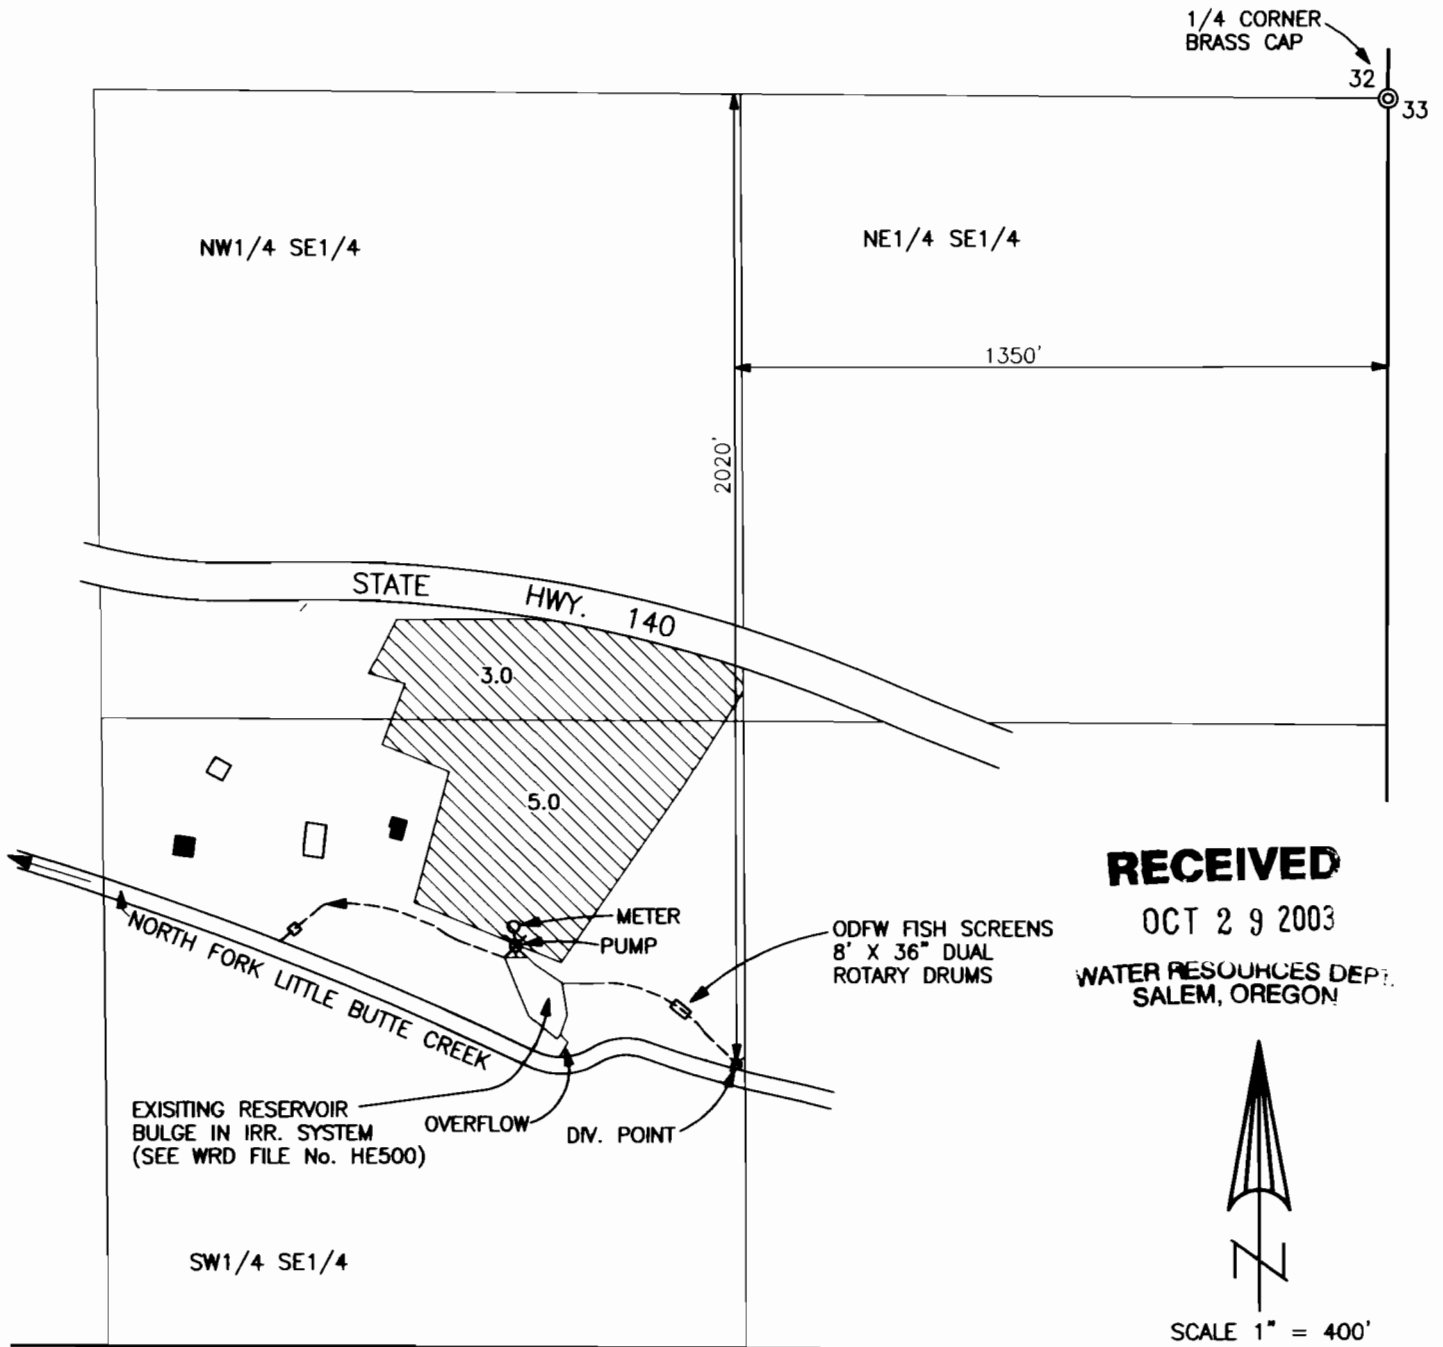

**RECEIVED**

OCT 29 2003

WATER RESOURCES DEPT.  
SALEM, OREGON



SCALE 1" = 400'

**CLAIM OF BENEFICIAL USE MAP**

APPLICATION No. T-9079

IN THE NAME OF:  
BILL & VIRGINIA SMITH

MAP PREPARED BY:  
GARY D. KAISER  
KAISER SURVEYING  
19440 HWY. 62  
EAGLE POINT, OR. 97524

OCTOBER 16, 2003

NOTE: MAP PREPARED FOR  
WATER RIGHT PURPOSES ONLY,  
NOT FOR PROPERTY BOUNDARY  
LOCATIONS.

