


CLAIM OF BENEFICIAL USE
 FOR M.C. OTIS
 BY DUANE W. KIRBY
 T26S, R3W, W.M. SEC 10
 T-10928
 TAX LOT 2300
 FISH SCREEN LOCATED AT THE POD
 METER LOCATED 110 FEET FROM POD
 IRRIGATION 8.1 ACRES AND DOMESTIC USE

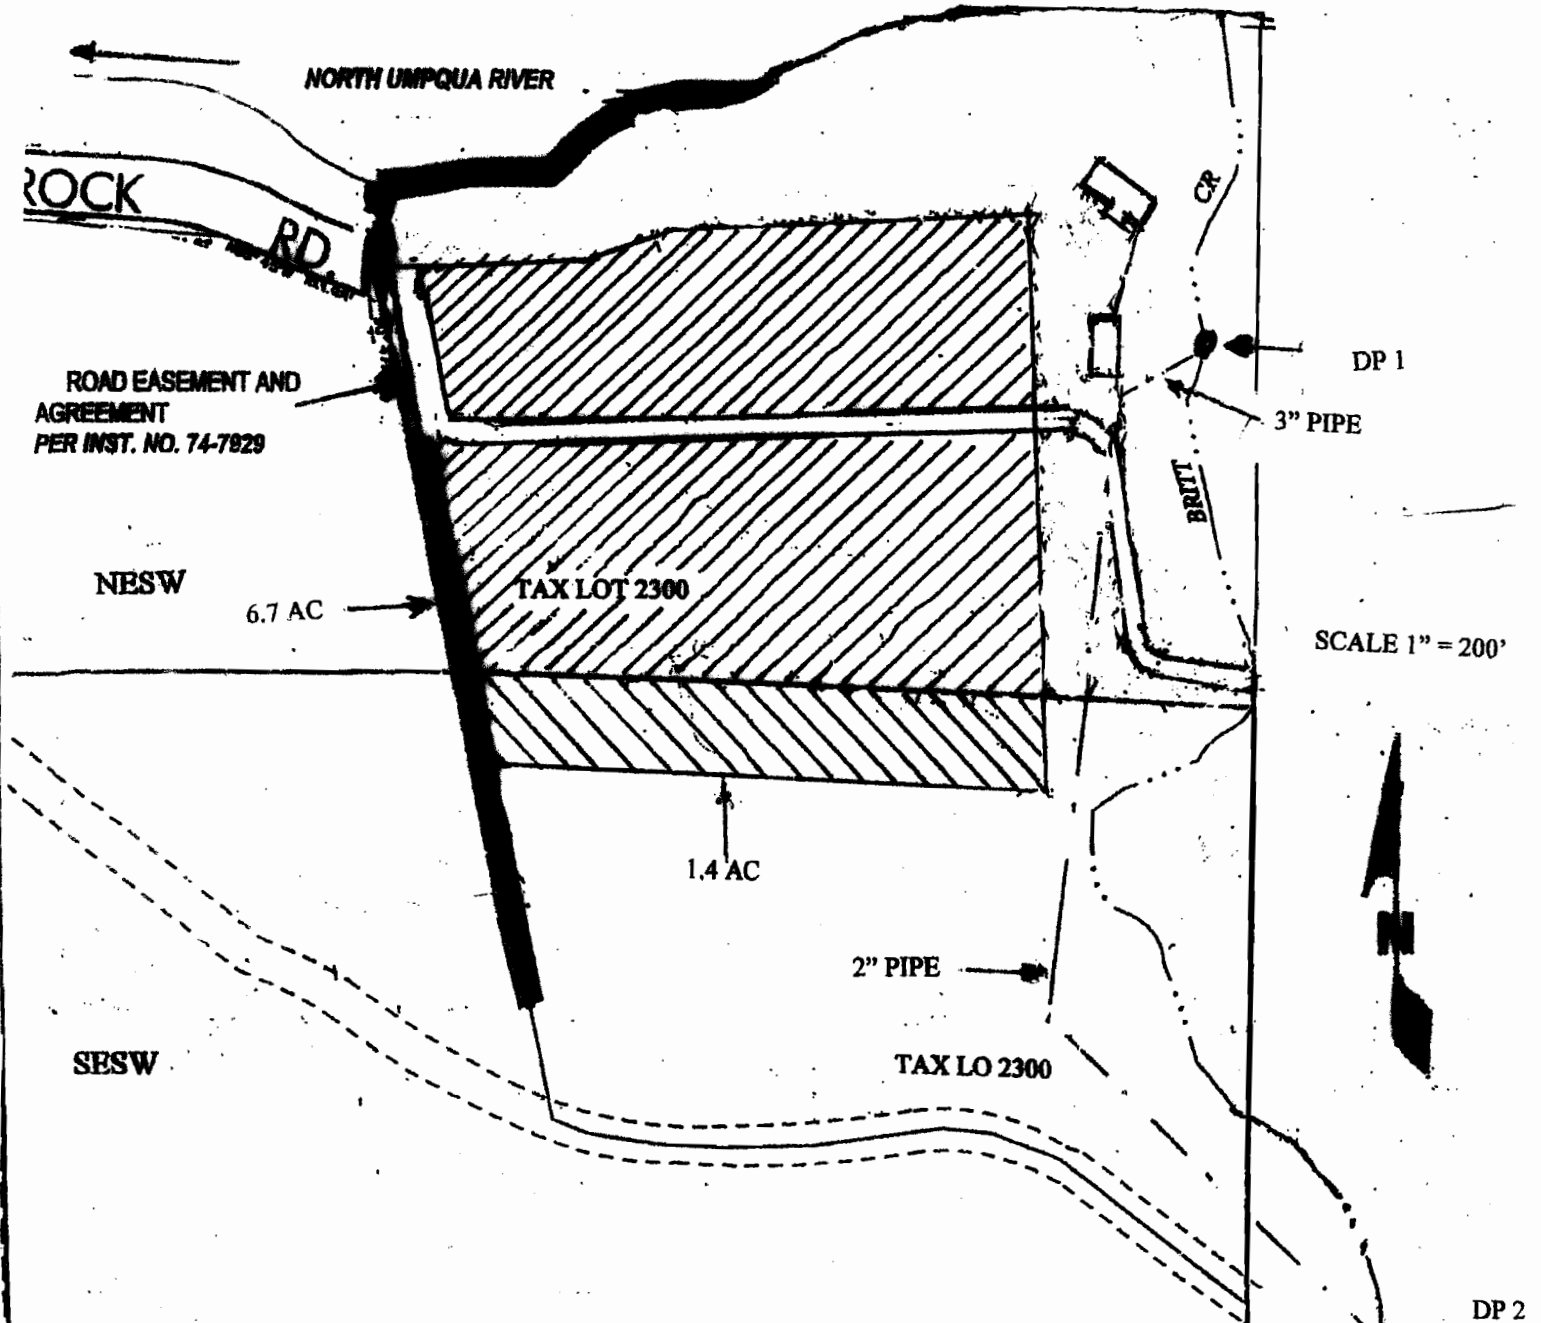

 ROAD AND BUILDINGS 0.6 AC NOT IRRIGATED

EXISTING TWO POINTS OF DIVERSIONS IS LOCATED IN THE SW $\frac{1}{4}$ SE $\frac{1}{4}$, SECTION 10, T26S, R3W, WM 670 FEET NORTH AND 140 FEET EAST; 400 FEET NORTH AND 50 FEET EAST, BOTH FROM THE S $\frac{1}{4}$ CORNER OF SECTION 10

ADDITIONAL POINT OF DIVERSION IS LOCATED 1690 FEET NORTH AND 60 FEET WEST FROM S $\frac{1}{4}$ CORNER SECTION 10

THE PURPOSE OF THIS MAP IS TO IDENTIFY THE LOCATION OF THE WATER RIGHT. IT IS NOT INTENDED TO PROVIDE INFORMATION RELATIVE TO LOCATION OF PROPERTY OWNERSHIP BOUNDARY LINES.

