


CLAIM OF BENEFICIAL USE
 FOR: SAM DEMANETT
 BY: DUANE W. KIRBY
 T19S, R2W WM, SEC 18
 TRANSFER NO. T-10444
 TAX LOT 504
 FISH SCREEN IS LOCATED AT THE POD

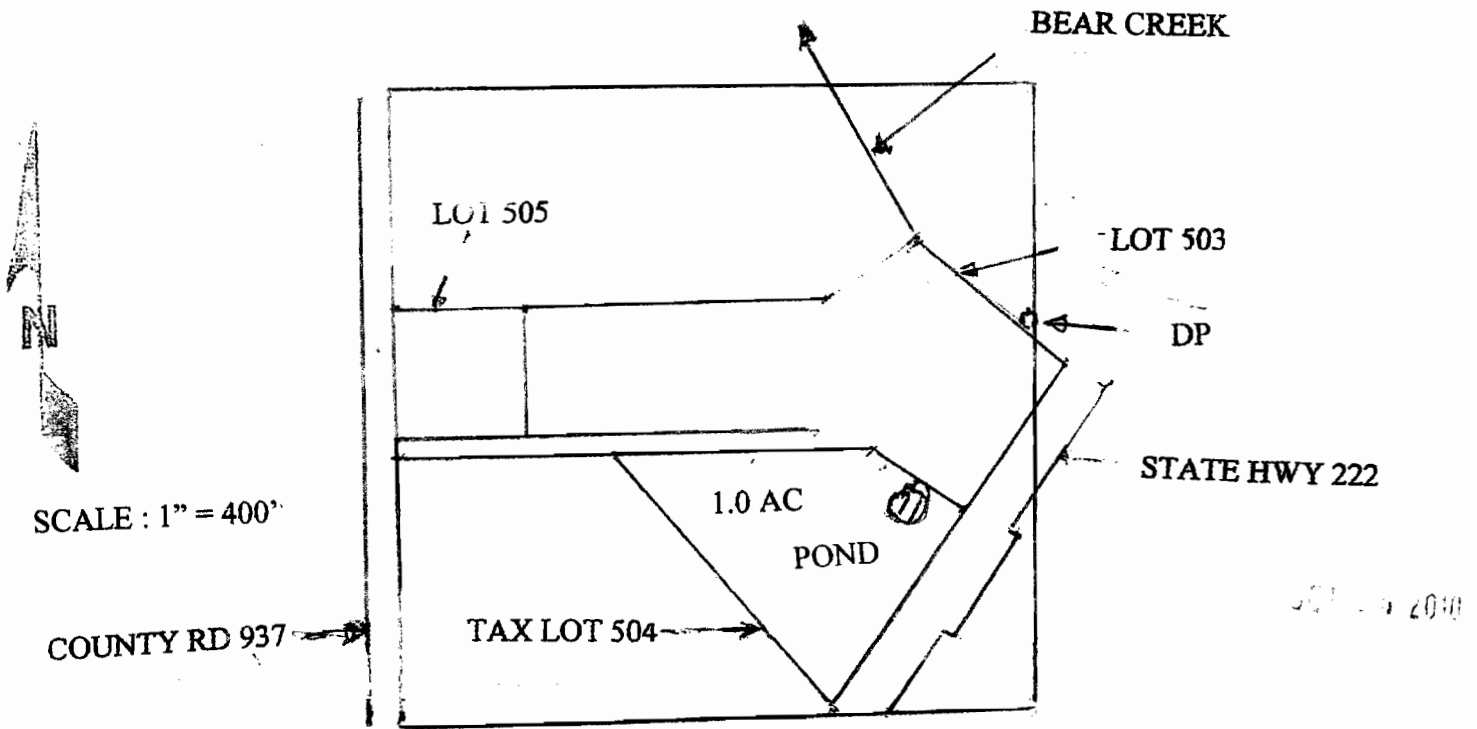

DIV. PT. 530 FEET SOUTH & 1270 FEET EAST FROM N $\frac{1}{4}$ COR, SEC 18

POND 860 FEET SOUTH & 1070 FEET EAST FROM N $\frac{1}{4}$ COR, SEC 18

POND MAINTENANCE

1.0 ACRES : LOT 504

THE PURPOSE OF THIS MAP IS TO IDENTIFY THE LOCATION OF THE WATER RIGHT. IT IS NOT INTENDED TO PROVIDE INFORMATION RELATIVE TO THE LOCATION OF PROPERTY OWNERSHIP BOUNDARY LINES.

