
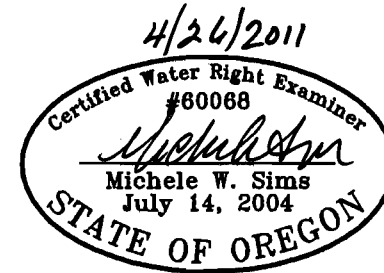
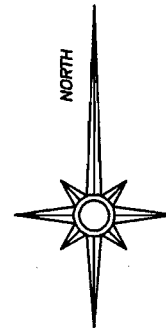


Claim of Beneficial Use

T-11139

Tax Lot 300, Map 15-11-19A

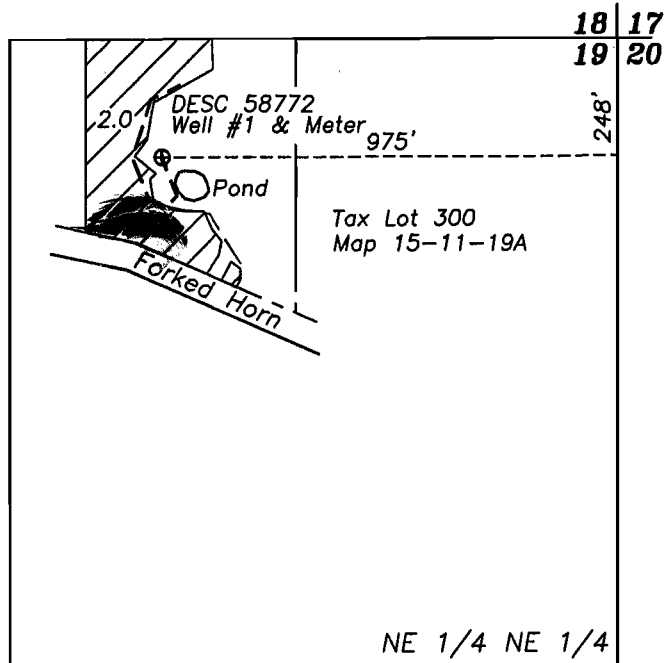

Renewal date: 6/30/2012

Sec. 19
T15S, R11E, W.M.
Deschutes Co., OR



Place of beneficial use under
T-11139 (Priority date 8/11/1993)




Well and meter location -



Mainline



Property boundary

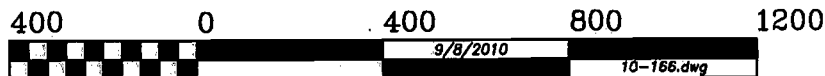

GRAPHIC SCALE - FEET

THIS MAP IS FOR THE PURPOSE OF IDENTIFYING THE LOCATION OF THE WATER RIGHT. IT IS NOT INTENDED TO PROVIDE LEGAL DIMENSIONS OR LOCATIONS OF PROPERTY OWNERSHIP LINES.