

MAP TO ACCOMPANY CLAIM FOR BENEFICIAL USE FOR TRANSFER OF SURFACE WATER P.O.D.

SECTION 11, T29S, R4W, WM
IN NAME OF


MELVIN K. GLASS

C 1/4 COR. S 11

TRANSFER T-9566
OF CERT. 42630

DATE JULY 22, 2006

BY: WILLIAM J. RUPPERT
P.O. BOX 1564
MYRTLE CREEK, OR 97457

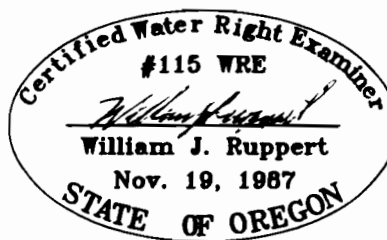


EXPIRES
12/31/2006

THIS MAP IS TO BE USED FOR WATER RIGHT PURPOSES ONLY

N0°34'00"E BASIS OF BEARINGS

1280.73

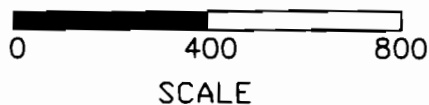

CO. RD 18

HOUSE

3/4" PIPE

SW 1/4
SE 1/4

SE 1/4
SE 1/4

N0°47'30"E

1284.69

TANKS

P.O.D.
SPRING CR.

495'

1865'

S 1/4 COR. S 11

1311.09

S87°39'00"E

1311.09

FND. MONUMENTED CORNER
BASED ON SURVEY BY
BLM, MARCH 1997

RECEIVED

JUL 26 2006

WATER RESOURCES DEPT
SALEM, OREGON