


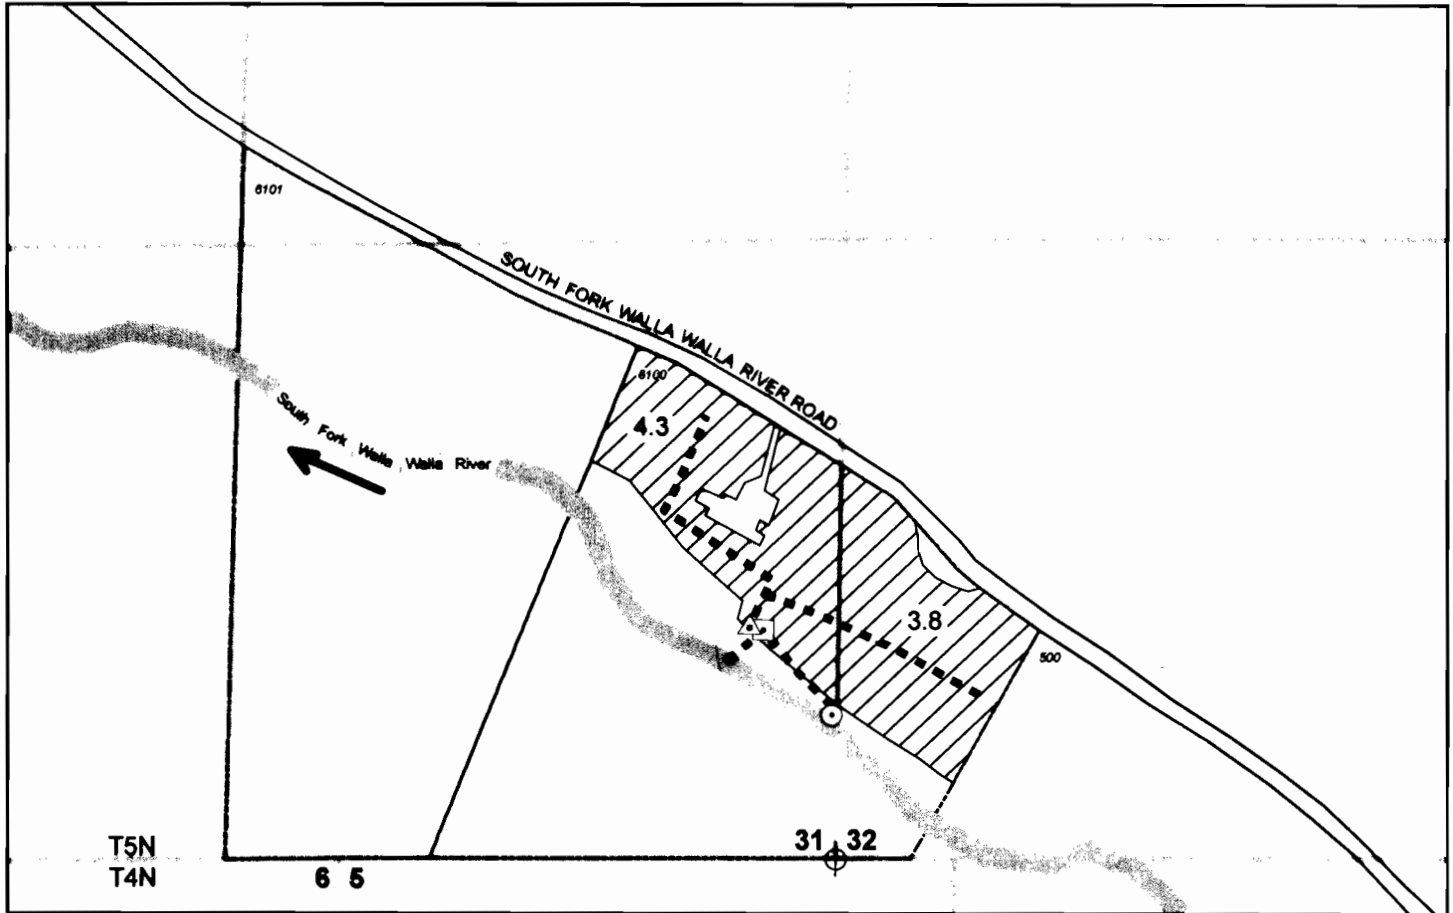

T5N, R37E, WM
Sections 31 & 32
Umatilla County

1 inch = 400 feet



○ **Point of Diversion**

Gravity diversion ditch located in SE/4 of SE/4 of Section 31, about 300 feet N from SE Corner of Section 31.

□ **Fish Screen**

Gravity drum fish screen with 6-inch PVC bypass pipe return to South Fork Walla Walla River.

△ **Pump Suction**

Centrifugal pump diverts water from open ditch. Flowmeter in same general location.

- - - **Conveyance**

Water conveyed from South Fork Walla Walla River to pump station via open ditch and culvert pipe.


Water conveyed from pump station to place of use via buried mainline (4-inch, 3-inch and 2-inch).

Water applied to grass pasture using brass impact sprinklers mounted on solid-set risers.

 **Place of Use**

8.1 acres in Tax Lot 6300:
4.3 ac in SE/4 SE/4 S31
3.8 ac in SW/4 SW/4 S32

The purpose of this map is to identify the location of a water right. It is not intended to provide information regarding the location of property ownership boundary

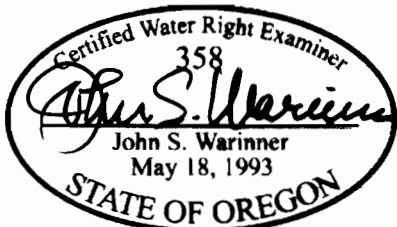

FOUNTAINHEAD
1860 Blue Creek Road
Walla Walla, WA 99362
509.529.2646 phone

**COBU MAP
Transfer 9794**

in the name of
DAVID ROBERTSON

Revised 25 APR 2008