DEC 2 2 1999


WATER RESOURCES DEPT. SALEM, OREGON

SECTION 26 TOWNSHIP 27 SOUTH, RANGE 17 EAST, W.M.

PE ON THE Y OAD 5-14F CORNER BETWEEN SECTIONS

FOUND 1 INCH IRON PIPE ON THE WESTERLY RIGHT-OF-WAY OF COUNTY ROAD 5-14F REFERENCING THE NORTHWEST CORNER OF SECTION 26

23 | 24

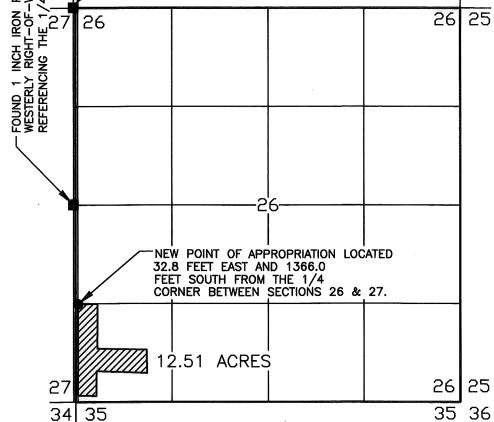

ALL OF THE AREA IRRIGATED IN THIS TRANSFER IS SITUATED IN THE SOUTHWEST 1/4 OF THE SOUTHWEST 1/4 OF SECTION 26 TOWNSHIP 27 SOUTH, RANGE 17 EAST, W.M.

FINAL PROOF SURVEY

FOR TRANSFER T-8059 PLACE OF USE AND NEW POINT OF APPROPRIATION LOCATED IN SECTION 26 TOWNSHIP 27 SOUTH, RANGE 17 EAST, W.M. LAKE COUNTY, OREGON TRANSFER APPLICATION T-8059

> LEGEND SECTION LINE

> > 1/4 SECTION LINE

1/16 SECTION LINE


- EXISTING WELL
- FOUND LAND SURVEY MONUMENT AS NOTED.

12.51 ACRES ARE BEING IRRIGATED FROM THE NEW WELL AS SHOWN, THE TOTAL PERMITTED FROM TRANSFER T-8059 IS 12.0 ACRE. 0.51 ACRES MORE THEN PERMITTED ARE BEING IRRIGATED.

SCALE: 1"=1320'

NOTE: PREPARATION OF THIS MAP IS FOR IDENTIFYING PROPOSED WATER RIGHTS ONLY. IT HAS NO INTENT TO PROVIDE LOCATIONS OR DIMENSIONS OF PROPERTY BOUNDARIES.

SEE ACCOMPANYING SITE REPORT

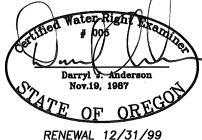

REVISION

ENGINEERING EYING, INC. P.O. BOX 419 ANDERSON ENGI AND SURVEYING

97641 SERRY OREGON PATRICK VALLEY, FOR: P.O. BOX 92 CHRISTMAS Ò PREPARED P.O. BOX § 541

DATE: 12/12/99 SCALE: 1"=1320' JOB: 98067 DWG. BY: M.J.B. FILE: 98067WRFP SHEET 1 OF 1