

Claim of Beneficial Use

Point of Appropriation T-11077

Point of Appropriation

964' North and 889' East from SW Corner of Section 21


Legend

— — — — — Property line

- - - - - Mainline




Place of Use, Certificate 75982,
priority date 5/16/1991


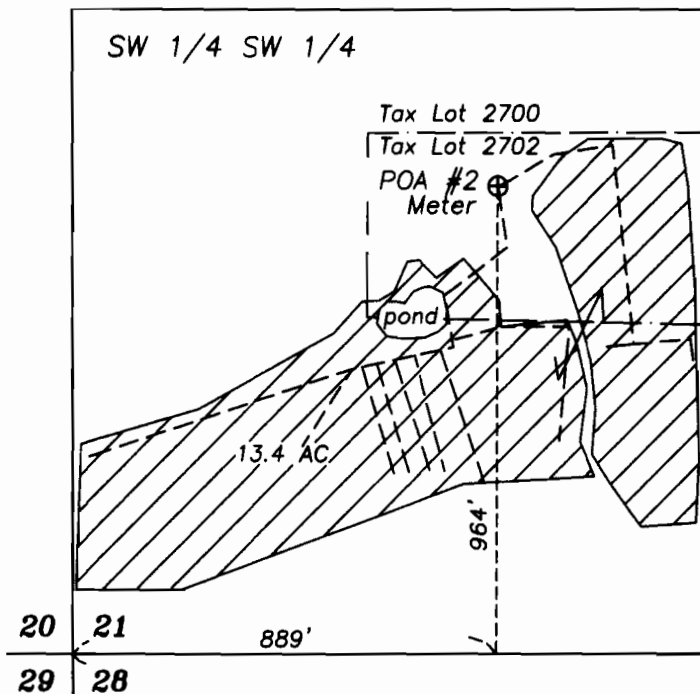


Section 21
T14S, R11E, W.M.
Deschutes Co., OR

Tax Lots 2700 and 2702, Map 14-11, Deschutes County

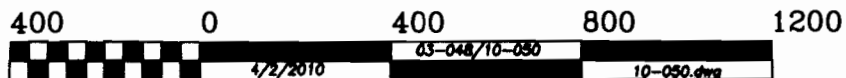

GRAPHIC SCALE - FEET

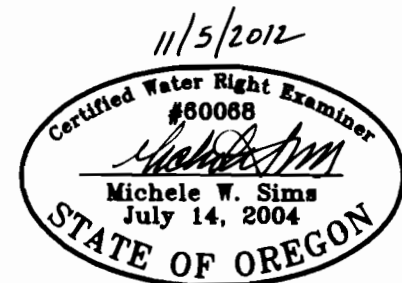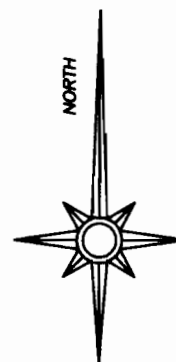

Renewal date: 6/30/2014

THIS MAP IS FOR THE PURPOSE OF IDENTIFYING THE LOCATION OF THE WATER RIGHT. IT IS NOT INTENDED TO PROVIDE LEGAL DIMENSIONS OR LOCATIONS OF PROPERTY OWNERSHIP LINES.