



NW 1/4 SECTION 8, T29S, R4W, WM

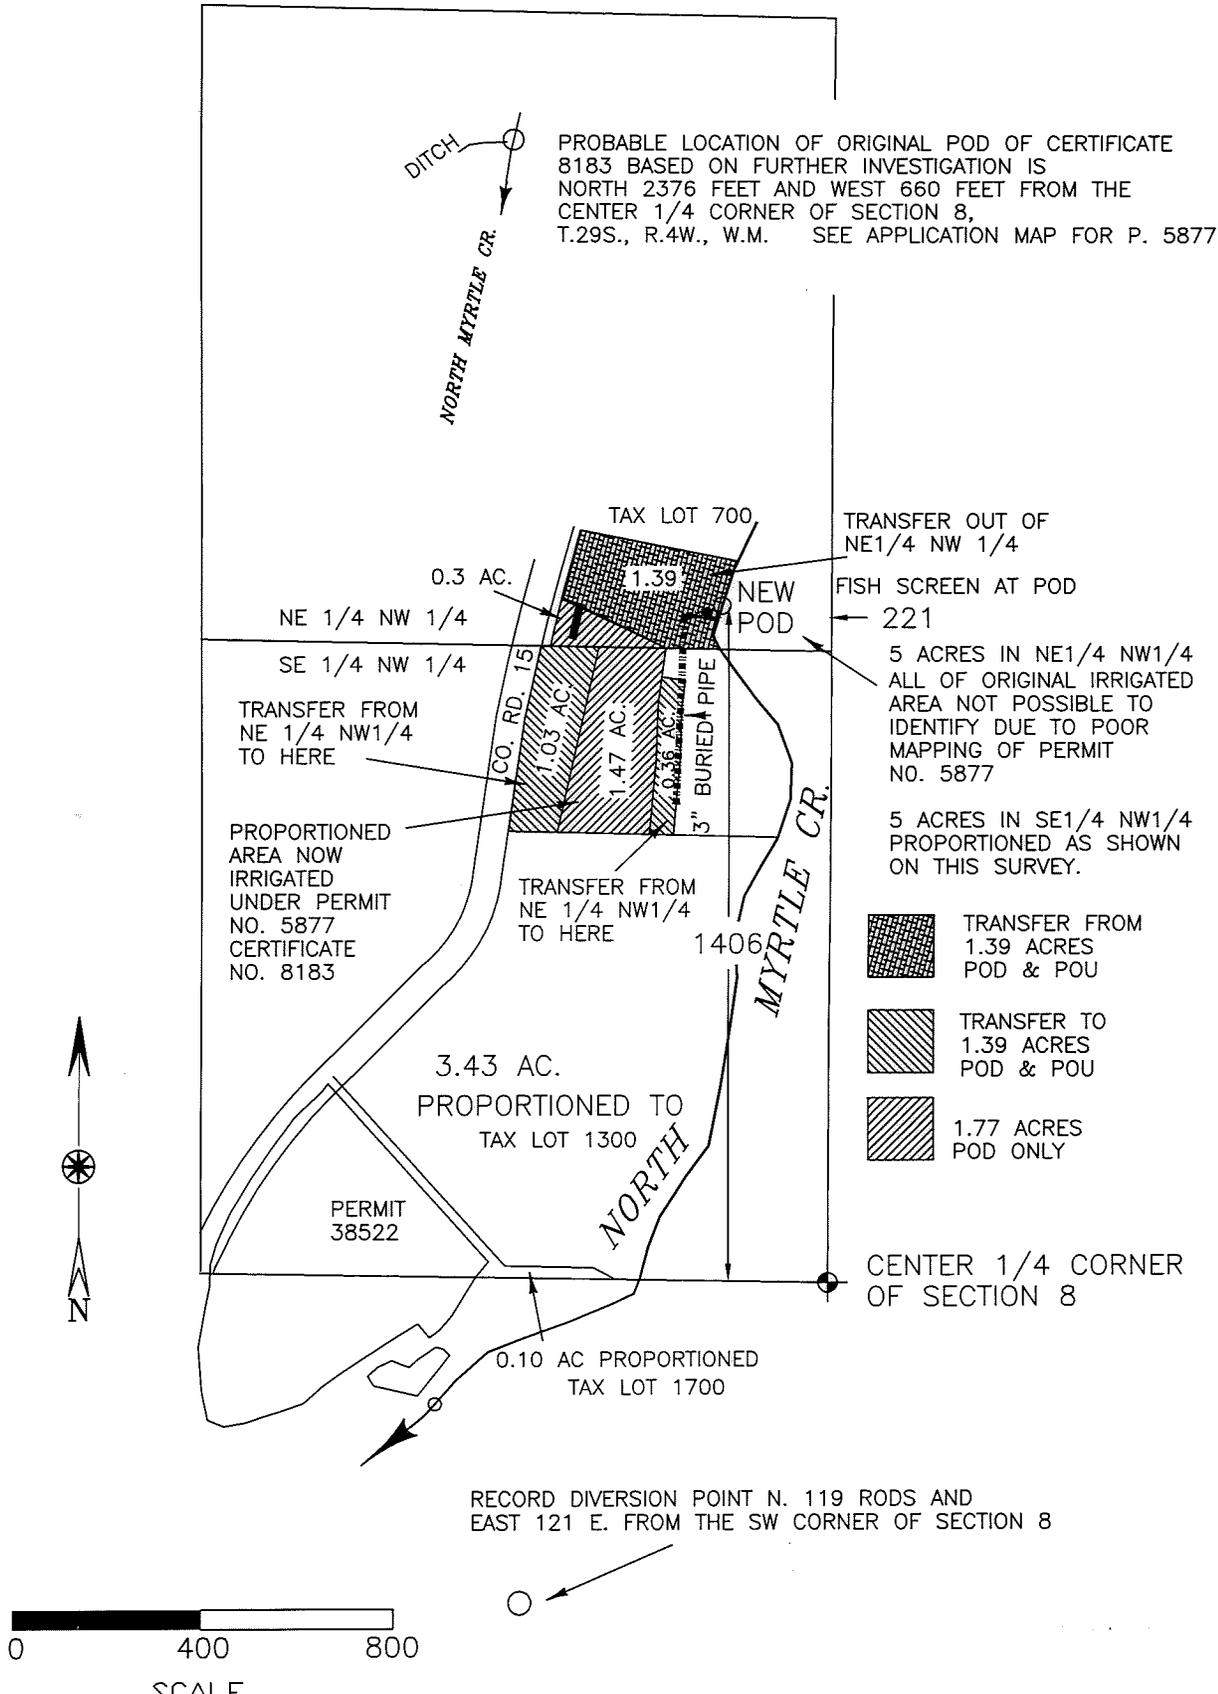

THIS MAP IS TO BE USED FOR WATER RIGHT PURPOSES ONLY

MAP TO ACCOMPANY CLAIM OF BENEFICIAL USE FOR TRANSFER T-8453
IN NAME OF *Mary Haigh* ORIGINALLY

NOW *Mark and Lisha Phillips*

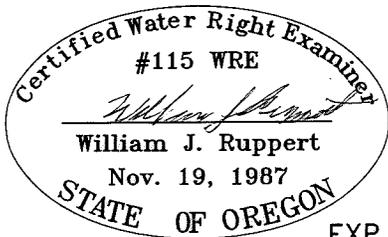

BY: WILLIAM J. RUPPERT
P.O. BOX 1564
MYRTLE CREEK, OR 97457
SEPTEMBER 13, 2010

EXP. 12/31/2010