

15 14
22 23

NW/4, NW/4 S23

NORTH FORK WALLA WALLA RIVER ROAD

900

NORTH FORK WALLA WALLA RIVER

1000

8.8

5.6

T5N, R36E, S23 WM
UMATILLA COUNTY



1 in = 400 ft

Quarter
Corner

SW/4, NW/4 S23



Fish Screen is located 1525 feet N and
288 feet E from W 1/4 Corner Sec 23.



Pump Station is located 1512 feet N and
266 feet E from W 1/4 Corner Sec 23.
Includes 5HP electric centrifugal pump
and 30HP PTO pump used when
needed.



Flume is located 1519 feet N and
246 feet E from W 1/4 Corner Sec 23.



WATER CONVEYANCE

Water is conveyed from POD to Pump
Station in open ditch and from Pump
Station to field with 4-inch buried PVC
mainline. Water is applied to orchard
with Nelson R2000 Rotators and to
pasture with Rainbird F30 impacts.




PLACE OF USE is 12.1 acres, including:
8.8 acres in NW/4, NW4, Section 23
5.6 acres in SW/4, NW/4, Section 23



POD is headgate located in the NW/4,
NW/4, Section 23, T5N, R36E, WM,
1537 feet North and 559 feet East from
the W 1/4 Corner of Section 23.

The purpose of this map is to
identify the location of a water
right. It is not intended to
provide information regarding
the location of property
ownership boundary lines.

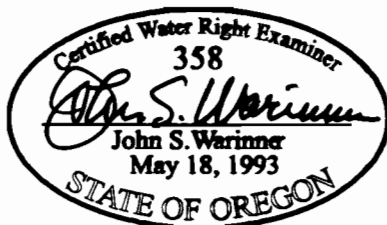

FOUNTAINHEAD
1860 Blue Creek Road
Walla Walla, WA 99362
Phone: 509.529.2646
Fax: 509.522.5251

FINAL PROOF SURVEY MAP
Transfer 8570
in the name of
Lance Bullock
55299 Walla Walla River Road
Milton-Freewater, OR 97862

Revised by John Warinner 29 JUN 2006