

15 | 14  
22 | 23

NW/4, NW/4 S23

NORTH FORK WALLA WALLA RIVER ROAD

900

NORTH FORK WALLA WALLA RIVER

8.8

5.6

T5N, R36E, S23 WM  
UMATILLA COUNTY



1 in = 400 ft

Quarter  
Corner

SW/4, NW/4 S23



Fish Screen is located 1525 feet N and 288 feet E from W 1/4 Corner Sec 23.



Pump Station is located 1512 feet N and 266 feet E from W 1/4 Corner Sec 23. Includes 5HP electric centrifugal pump and 30HP PTO pump used when needed.



Flume is located 1519 feet N and 246 feet E from W 1/4 Corner Sec 23.




**WATER CONVEYANCE**  
Water is conveyed from POD to Pump Station in open ditch and from Pump Station to field with 4-inch buried PVC mainline. Water is applied to orchard with Nelson R2000 Rotators and to pasture with Rainbird F30 impacts.

**PLACE OF USE** is 12.1 acres, including:  
8.8 acres in NW/4, NW4, Section 23  
5.6 acres in SW/4, NW/4, Section 23



POD is headgate located in the NW/4, NW/4, Section 23, T5N, R36E, WM, 1537 feet North and 559 feet East from the W 1/4 Corner of Section 23.

The purpose of this map is to identify the location of a water right. It is not intended to provide information regarding the location of property ownership boundary lines.

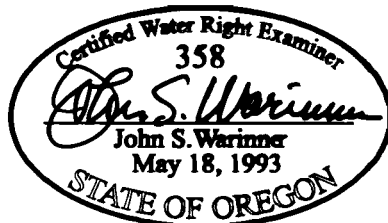

**FOUNTAINHEAD**  
1860 Blue Creek Road  
Walla Walla, WA 99362  
Phone: 509.529.2646  
Fax: 509.522.5251

**FINAL PROOF SURVEY MAP**  
Transfer 8570  
in the name of  
Lance Bullock  
55299 Walla Walla River Road  
Milton-Freewater, OR 97862  
Revised by John Warinner 29 JUN 2006