

15 | 14
22 | 23

NW/4, NW/4 S23

NORTH FORK WALLA WALLA RIVER ROAD

900

NORTH FORK WALLA WALLA RIVER

1000

8.8

5.6

T5N, R36E, S23 WM
UMATILLA COUNTY



1 in = 400 ft

Quarter
Corner

SW/4, NW/4 S23

● POD is headgate located in the NW/4, NW/4, Section 23, T5N, R36E, WM, 1537 feet North and 559 feet East from the W 1/4 Corner of Section 23.

○ Fish Screen is located 1525 feet N and 288 feet E from W 1/4 Corner Sec 23.


□ Pump Station is located 1512 feet N and 266 feet E from W 1/4 Corner Sec 23. Includes 5HP electric centrifugal pump and 30HP PTO pump used when needed.

△ Flume is located 1519 feet N and 246 feet E from W 1/4 Corner Sec 23.

----- WATER CONVEYANCE
Water is conveyed from POD to Pump Station in open ditch and from Pump Station to field with 4-inch buried PVC mainline. Water is applied to orchard with Nelson R2000 Rotators and to pasture with Rainbird F30 impacts.

▨ PLACE OF USE is 12.1 acres, including:
8.8 acres in NW/4, NW4, Section 23
5.6 acres in SW/4, NW/4, Section 23

The purpose of this map is to identify the location of a water right. It is not intended to provide information regarding the location of property ownership boundary lines.

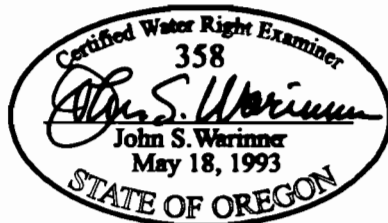

FOUNTAINHEAD
1860 Blue Creek Road
Walla Walla, WA 99362
Phone: 509.529.2646
Fax: 509.522.5251

FINAL PROOF SURVEY MAP
Transfer 8570
in the name of
Lance Bullock
55299 Walla Walla River Road
Milton-Freewater, OR 97862
Revised by John Warinner 29 JUN 2006