


Claim of Beneficial Use Transfer No. T-9522


A Parcel of Land Situated in the NE 1/4 of
Sec. 4, T15S, R10E, W.M., Deschutes County,
Oregon

In the name of Michael Broadbent

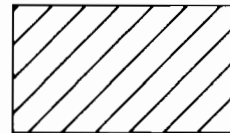




Area beneficially irrigated under
Transfer No. T-9522

(Certificate No. 72242, Priority Date 12/17/1990)

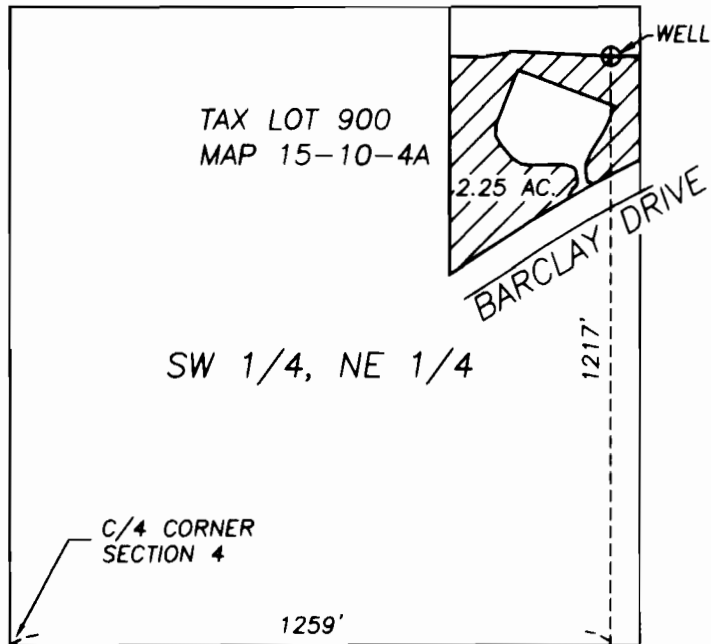

T15S, R10E, W.M.
DESCHUTES COUNTY, OR

THIS MAP IS FOR THE PURPOSE OF IDENTIFYING THE LOCATION OF THE WATER RIGHT.
IT IS NOT INTENDED TO PROVIDE LEGAL DIMENSIONS OR LOCATIONS OF PROPERTY
OWNERSHIP LINES.

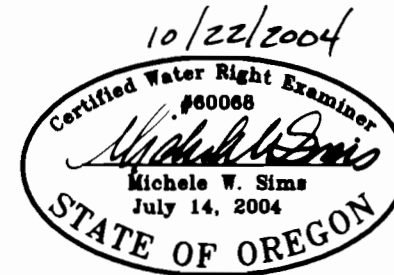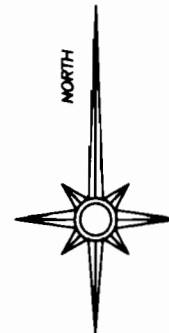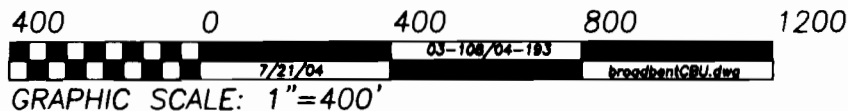

RECEIVED

NOV 04 2004

WATER RESOURCE DEPT
SALEM, OREGON