

FINAL PROOF MAP - PERMIT G-14024


LOCATED IN
SECTION 27, T. 19 S., R. 22 E., W.M.
CROOK COUNTY, OREGON

RECEIVED BY OWRD

OCT 22 2012

SALEM, OR

A.C. WELL LOCATION IS 2518 FT. SOUTH AND
2033 FT. EAST OF THE NORTHWEST CORNER OF SEC. 27.

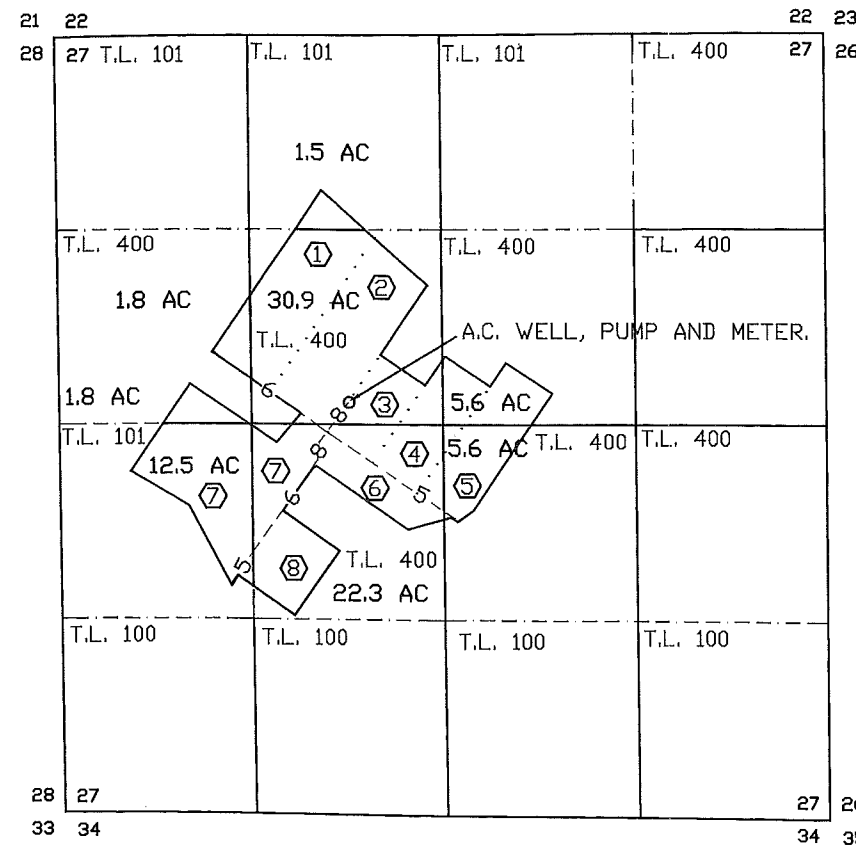


82.0 AC TOTAL

LEGEND

- 8 ----- MAINLINE AND SIZE IN INCHES
- TAX LOT LINE
- FIELD BOUNDARY
- ② FIELD NUMBER

I, ROBERT E. BAXTER, CERTIFIED WATER RIGHT EXAMINER
IN THE STATE OF OREGON, HEREBY CERTIFY THAT THIS
WATER RIGHT SURVEY MAP WAS PREPARED BY ME.

THE PREPARATION OF THIS MAP IS FOR THE PURPOSE
OF IDENTIFYING THE LOCATION OF THE WATER RIGHT
ONLY AND HAS NO INTENT TO PROVIDE DIMENSIONS OR
LOCATIONS OF PROPERTY OWNERSHIP LINES.

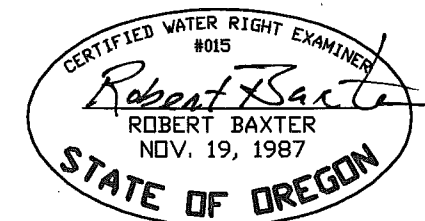

COBU MAP # 726
folded ✓

PREPARED BY
BAXTER LAND SURVEYING, INC.
20370 EMPIRE AVE. SUITE C3
BEND, ORE. 97701 (541) 382-1962

CLAIM OF BENEFICIAL USE MAP
FOR
NORM HYATT

PREPARED FOR: NORM HYATT
5102 SCENIC DRIVE
YAKIMA, WA 98908 (509)-966-2309
SCALE: 1" = 1320'
DATE: 6-13-2012