


Appl 12609

Amended MAP

Accompanying final proof of Danniel J. Sullivan of Ashland, Oreg.
to waters of Spring (unnamed) tributary of Keene Creek
Jackson County, Oregon. for domestic use.

July 1930

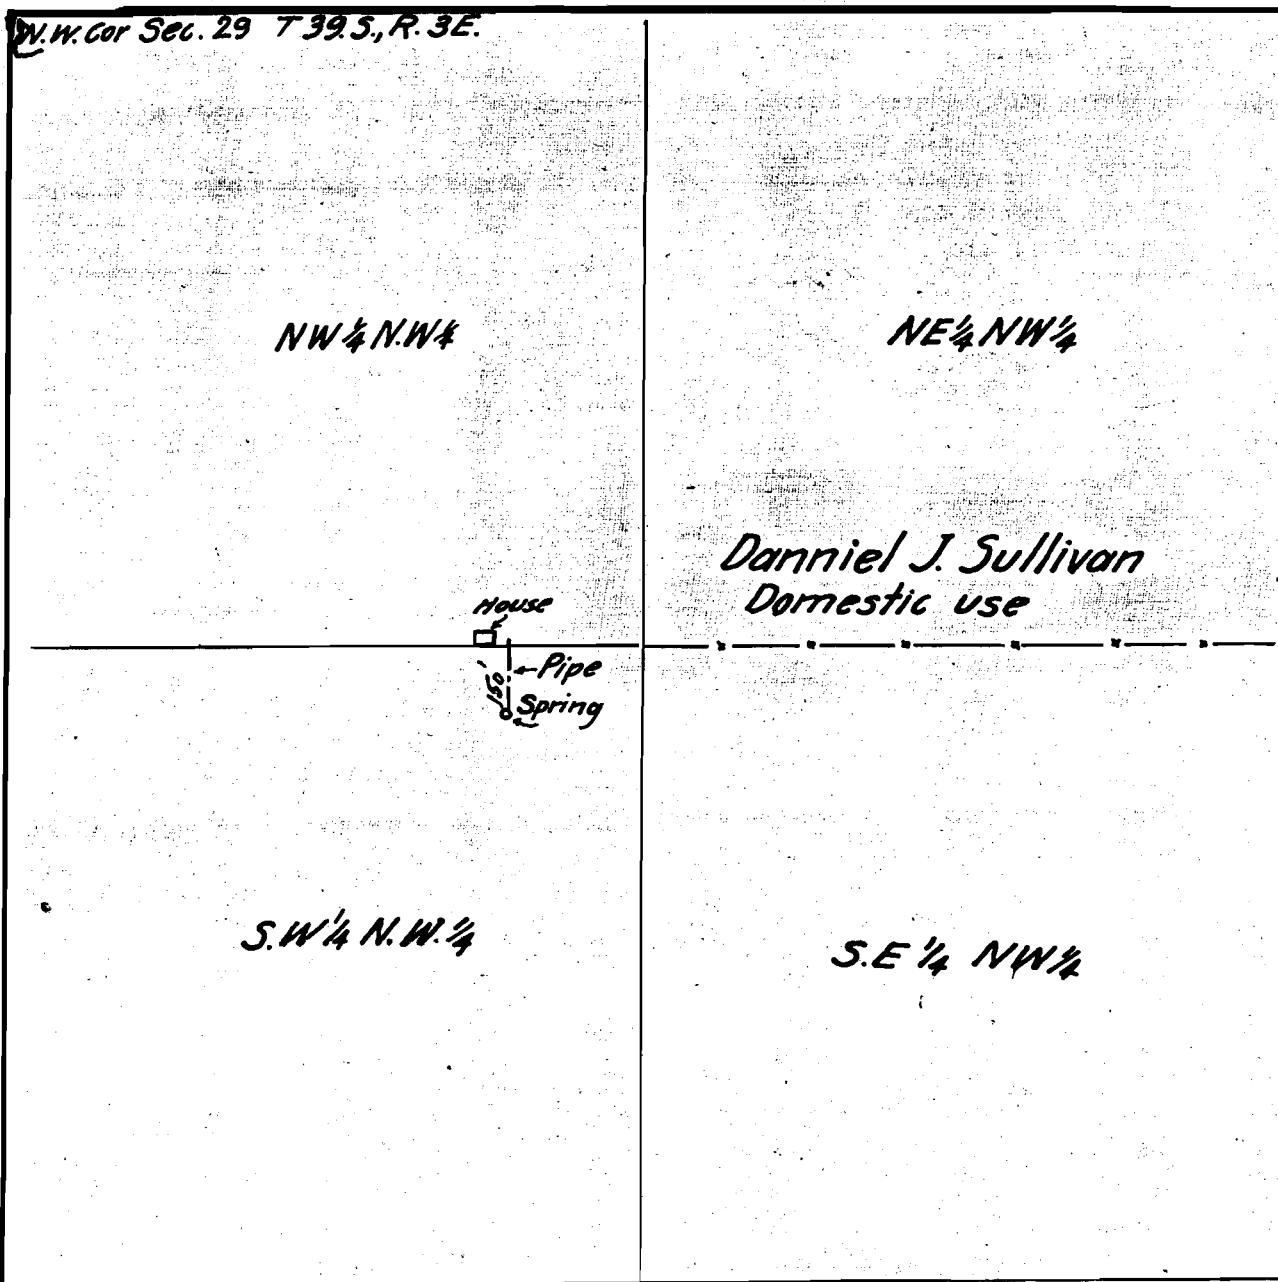

Map made from Plane Table Survey in field by Chester Cummings
showing location of spring and place of use
Compiled by
Chester Cummings

Keene Ck. Misc.


8947
292

Appl 12609

— MAP —

Accompanying application of Daniel J. Sullivan of Ashland
Jackson Co. Oregon for Permit to the waters of Spring
tributary to Keene Creek. Jackson Co. Oregon.
Water to be used for Domestic purposes.

— March 1929. —

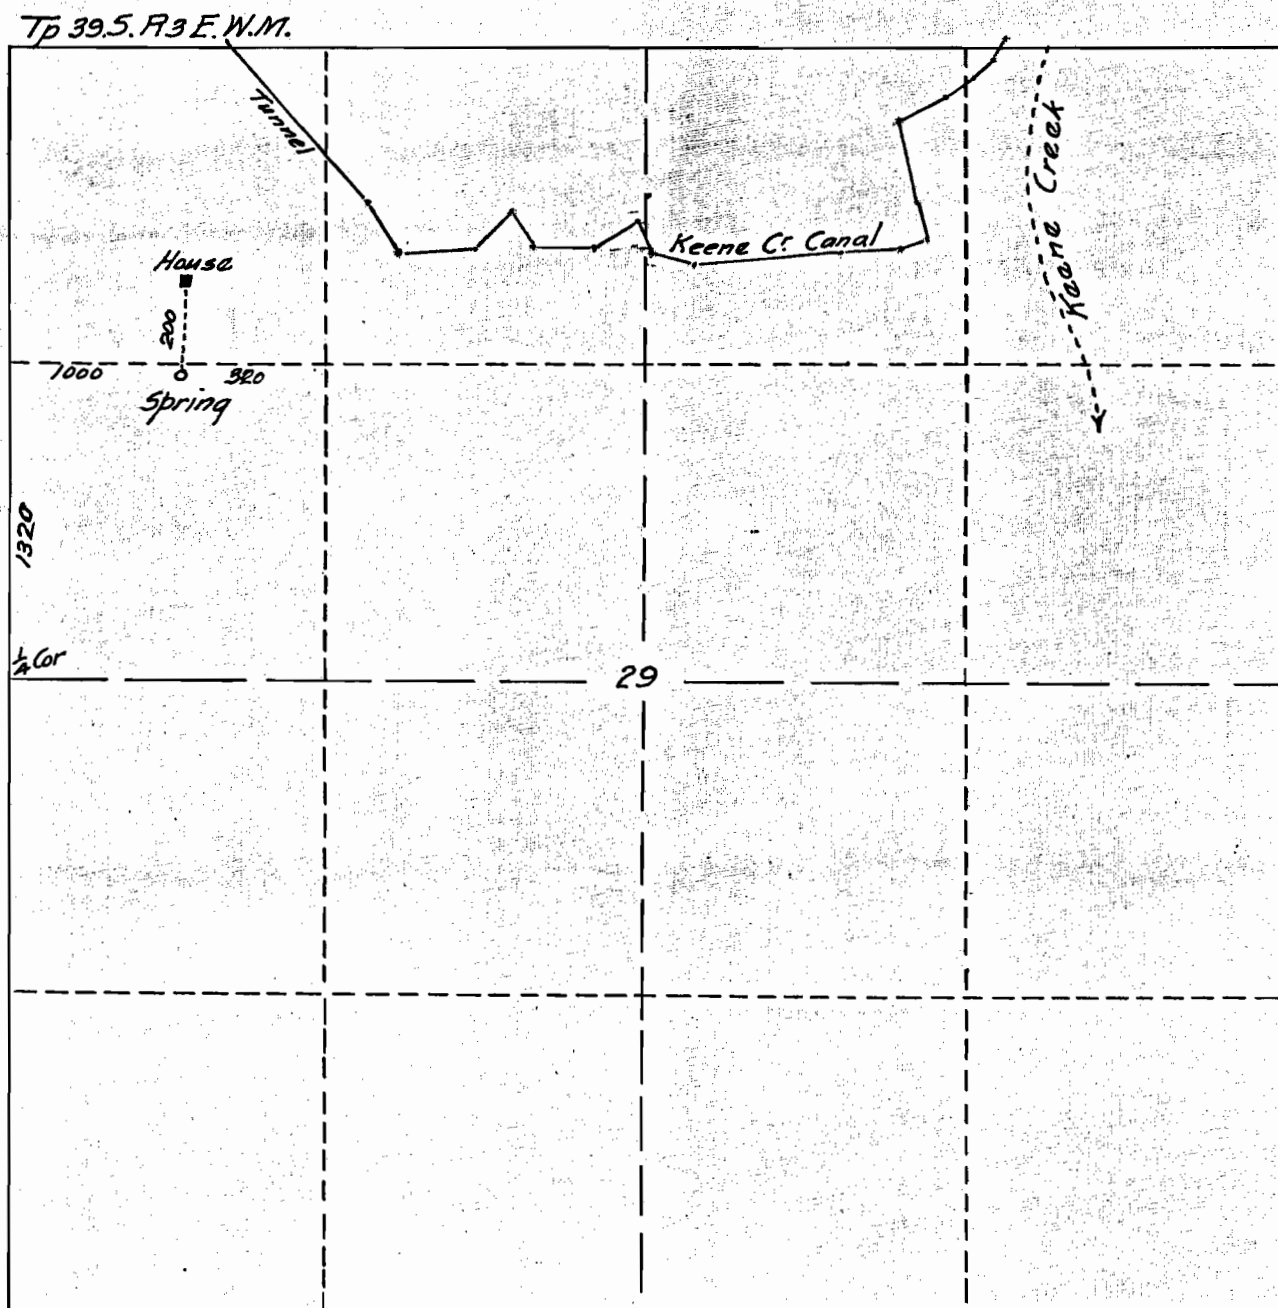

Map made from measurements made in the field by Mr.
Sullivan the same showing correctly location of Spring
and place of use, to-gether with streames and ditches
in immediate vicinity. compiled by.

Application No. 12609

— Fred. N. Cummings. C.E. —

Permit No. 8947

12609