

T-9047

FINAL PROOF MAP
SW1/4NW1/4 & NW1/4SW1/4 Section 28
NE1/4SE1/4 Section 29
Township 39 South, Range 7 West
Willamette Meridian, Josephine County, Oregon


For
Douglas Frank
8940 Holland Loop Road, Cave Junction, OR. 97523

LEGEND




Date: August 31, 2004
Scale 1" = 400'

- Survey Monument
- Denotes Building

 Denotes area under Special Order Volume 57, Pages 452-455, Priority Date 1957 Tract # 1.

 Denotes area under Special Order Volume 57, Pages 452-455, Priority Date 1968, Tract # 4

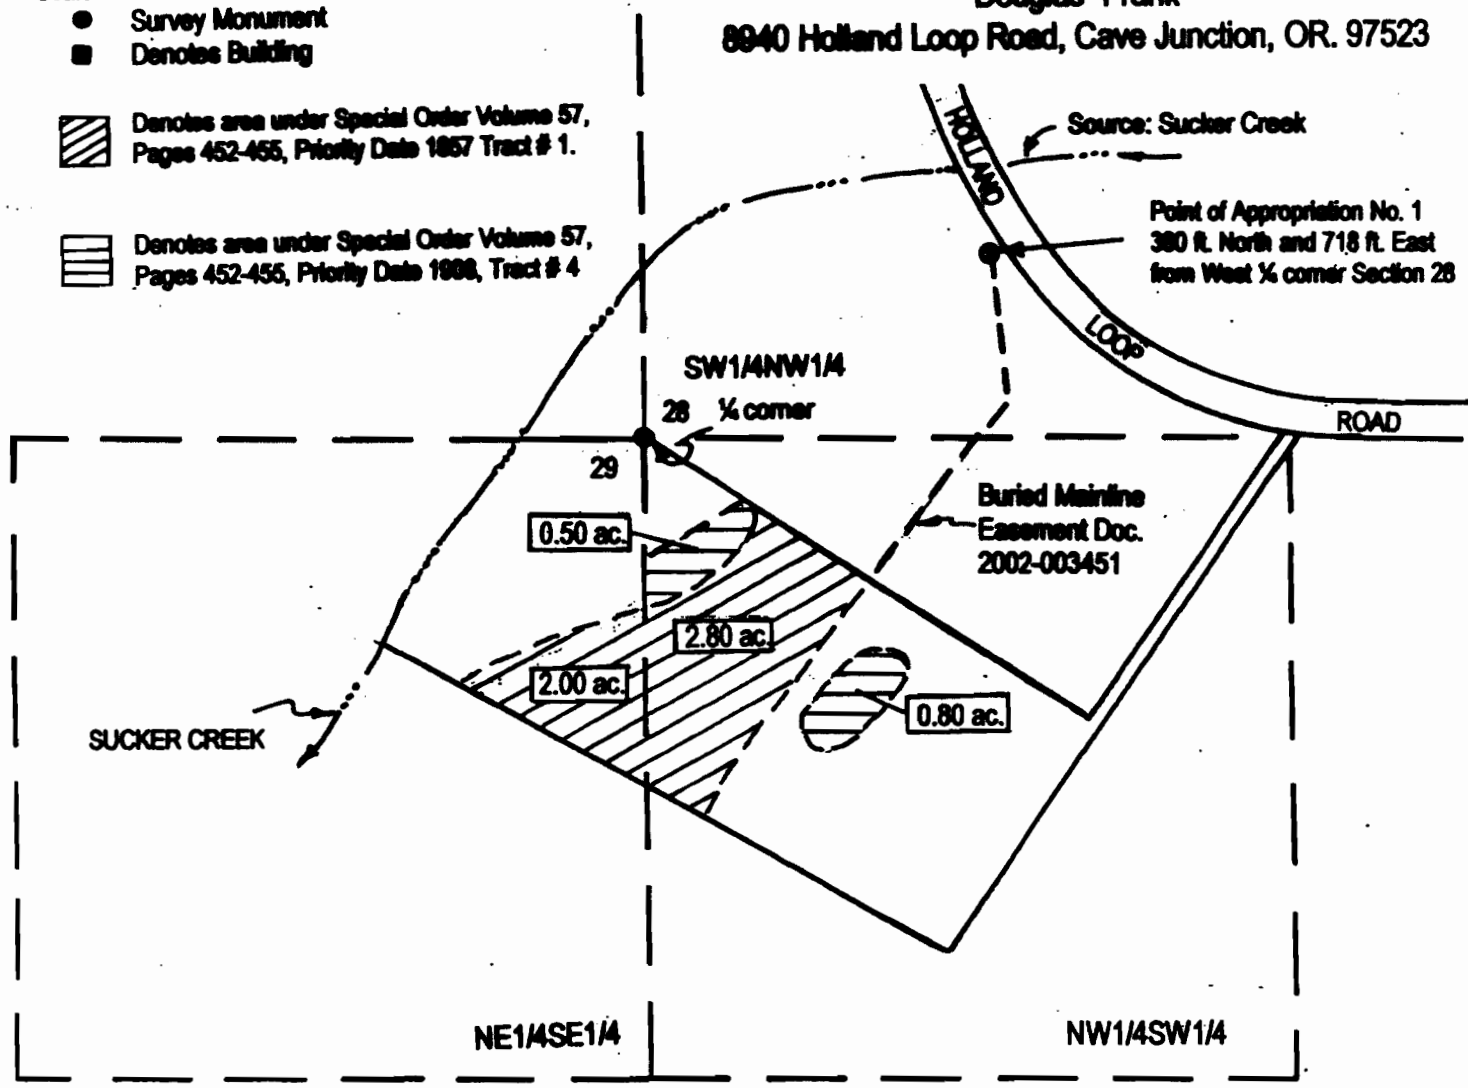

RECEIVED
SEP 22 2004
WATER RESOURCES DEPT
SALEM, OREGON

Certified Water Right Examiner
HAROLD L. CENTER, P.L.S., C.W.R.E.
2604 David Lane - Medford, Or. 97504
541-535-6108, Fax 541-535-8752
Oregon C.W.R.E. No. 152
Certificate Renewal Date - 12-31-2005



This map was prepared for the purpose of identifying the location of a water right only and is not intended to provide legal dimensions or location of property ownership lines.