


MAP

Accompanying Final Proof of Permit No. 8966 App. No. 12619
in name of J.L. Ragsdale of Trail Oregon Jackson Co.
Correctly showing survey of May 1930

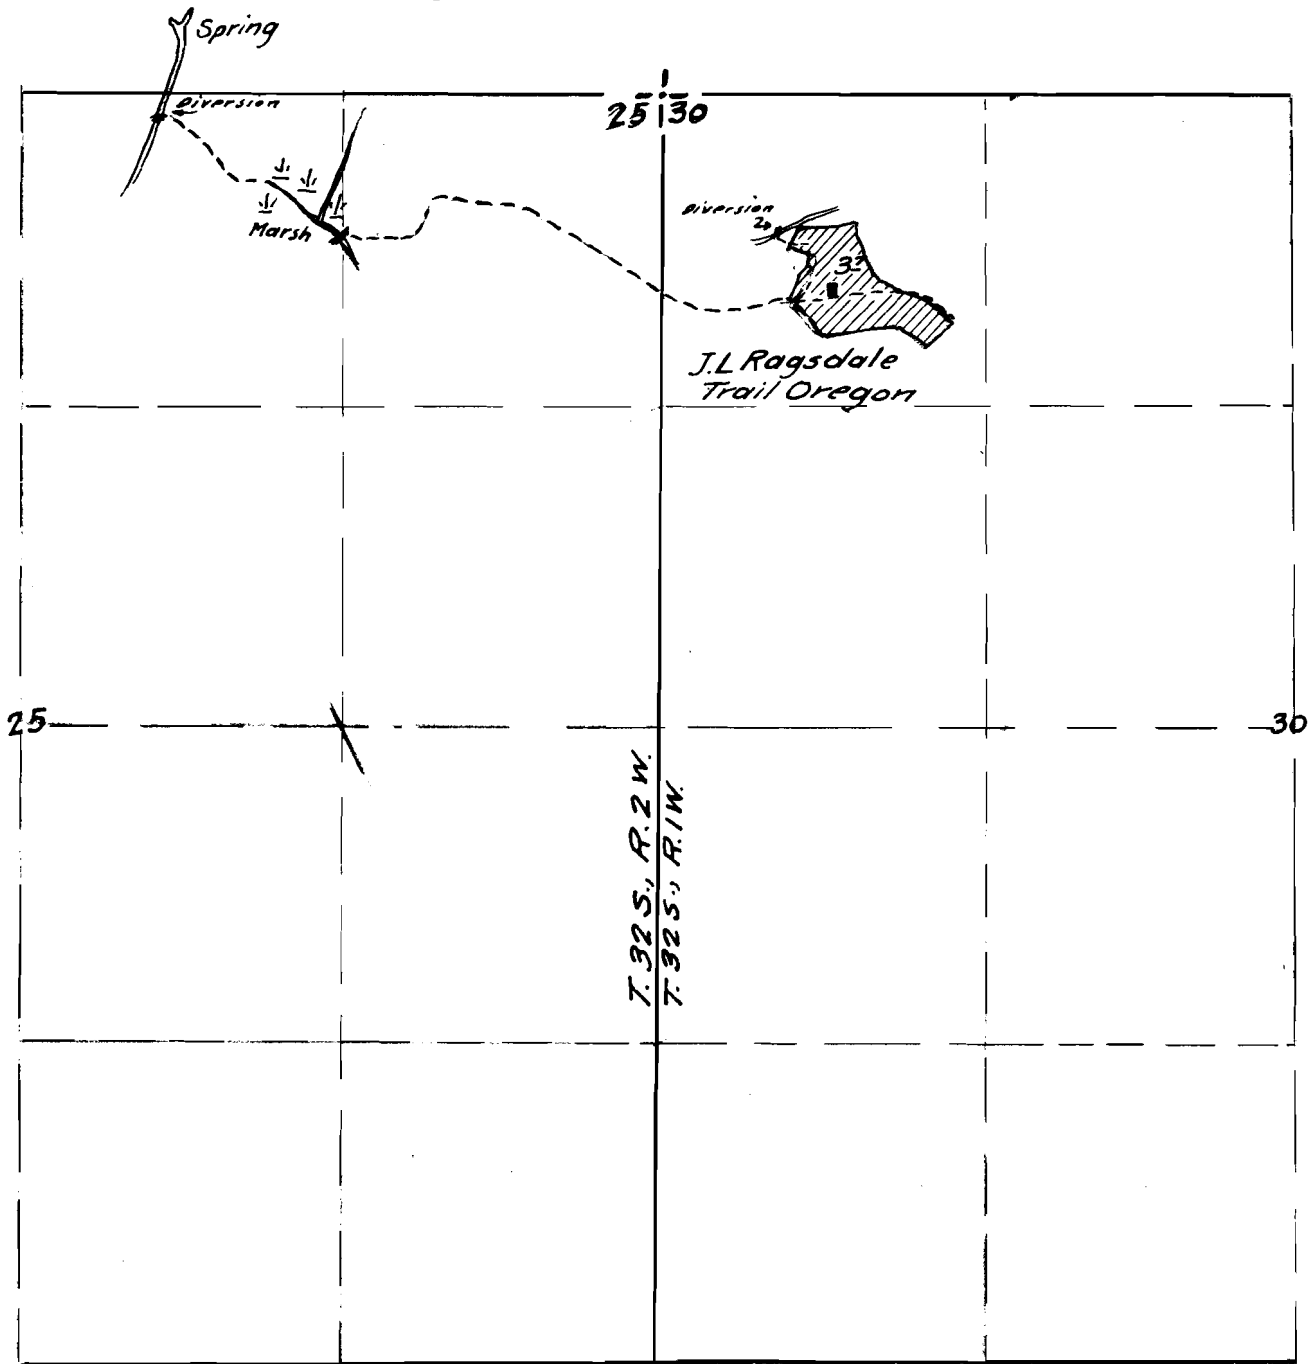

Map made from survey by Chester A. Cummings
showing lands irrigated and ditch system
under Permit No. 8966

12619