


CLAIM OF BENEFICIAL USE MAP TRANSFER T-10896
FOR
LAUREL CREEK ACRES LLC – MR. JIM PATRICK, GENERAL MANAGER
28900 SE W.K. ANDERSON ROAD
GRESHAM, OR 97080
IN
SECTIONS 30 AND 31
TOWNSHIP 29 SOUTH, RANGE 14 WEST, W.M.
COOS COUNTY, OREGON



Scale: 1"=1320'
Date: Sept. 23, 2010


LEGEND

- Found Survey Monument
- Denotes Building/Structure
- Ⓜ Denotes Flow Meter
- Ⓟ Denotes Primary Pump
- ⓅⓂ Denotes Pump at Bulge
- Denotes Area Under Cert. 39509, Priority Date June 16, 1966
- Denotes Mainline Pipe

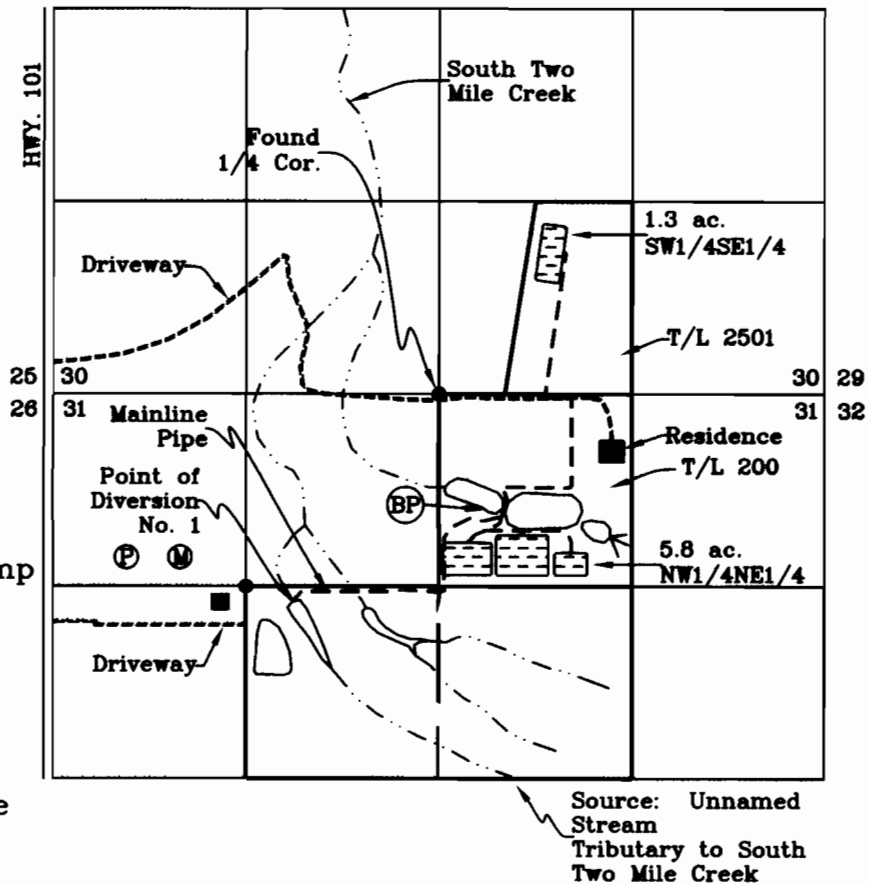

Point of Diversion No. 1 is located 1450 ft. South and 980 ft. West from the North Quarter Corner of Section 31 within the SE1/4NW1/4 of Section 31. Fish screen at intake Point of Diversion No. 1. Staff gages and in channel weirs are installed at POD No. 1 and "Bulge" reservoirs.

This map was prepared for the purpose of identifying the location of a water right only and is not intended to provide legal dimensions or location of property ownership.

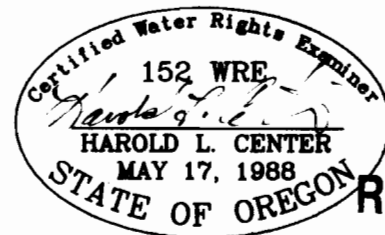

RECEIVED

JCT 18 2010

HAROLD L. CENTER
2604 David Lane
Medford, OR. 97504
Phone 541-535-6108
Oregon Certificate No. 152
Cert. Renewal Date: 12/31/2011

WATER RESOURCES DEPT
SALEM, OREGON