

Claim of Beneficial Use

T35S, R4W, Sec. 9


T-10764

Robert and Janice Bradford


9100 West Evans Cr

541-582-2487

354W09-800

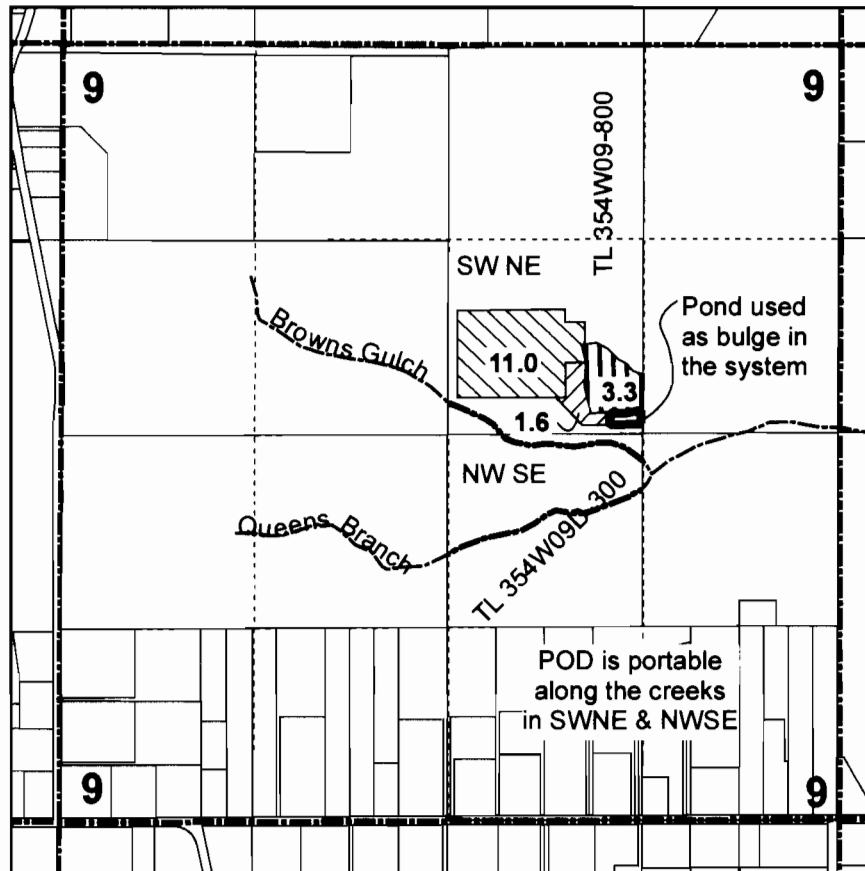

RECEIVED

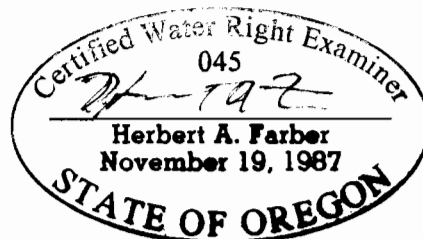

This map is not intended to provide legal dimensions or locations of property ownership lines

WATER RESOURCES DEPT
SALEM, OREGON

RENEWAL DATE 12-31-11


Legend

--- POD reach

Irr from Queens Branch only

Irr from Queens Branch & Browns Gulch

Existing Cert 29710

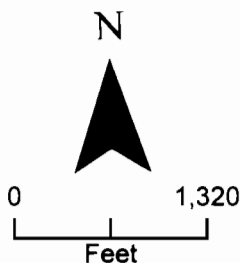

FARBER
SURVEYING

PO Box 5286
Central Point, Oregon 97502
Phone 541-664-5599
Fax 541-664-5603
Email hafarber@charter.net

Farber & Sons, Inc.
431 Oak Street
Central Point, Oregon
Tax ID: 93-1057173