


T. 9 S., R. 39 E., W.M.

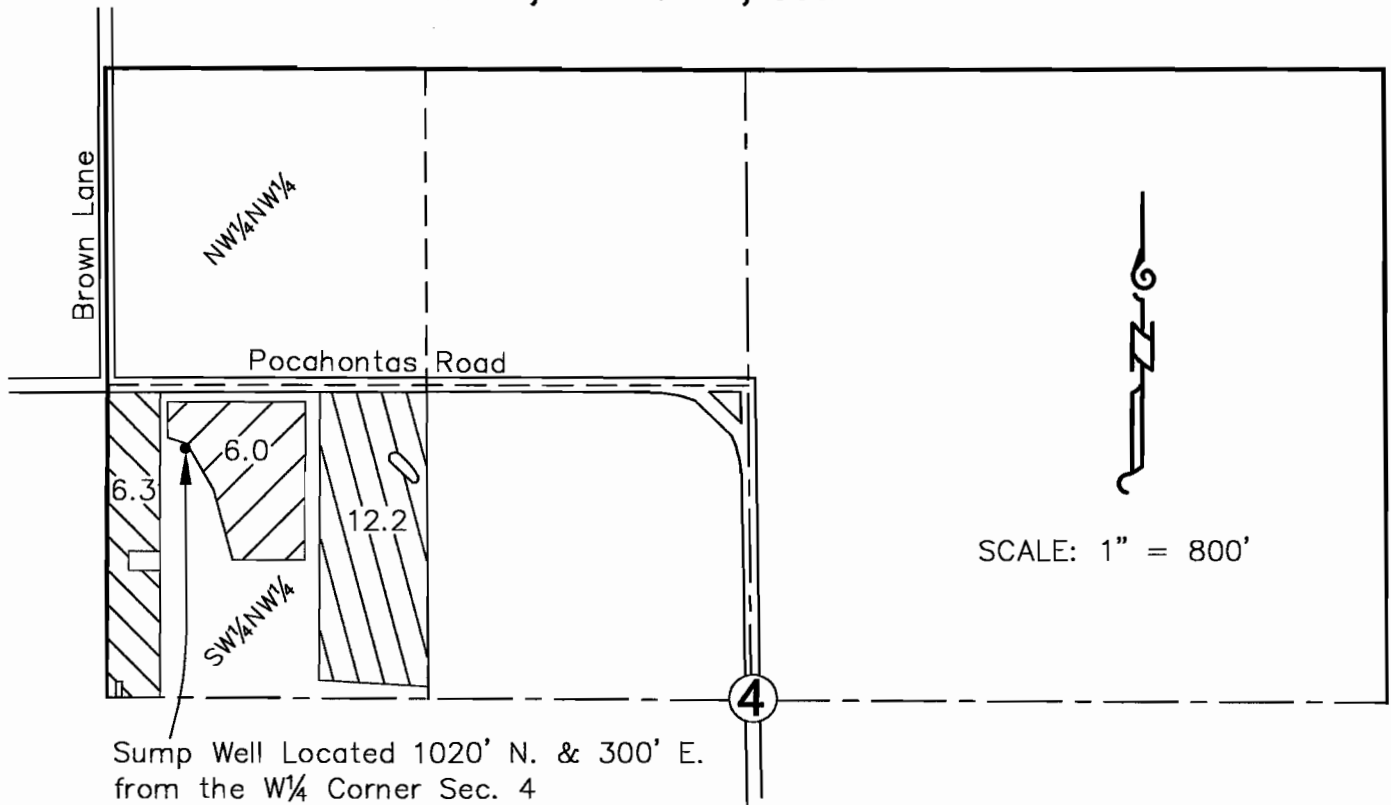

LEGEND

-  Irrigated Lands with Sump
-  Remaining Rights C 37875
-  Remaining Rights C 39252


This map is for the purpose of identifying the water right location only and is not intended to provide legal dimensions or location of property ownership lines.

FINAL PROOF SURVEY

In Name of
Darrell & Betty Endicott
Reference: T-7859

Site Survey June 20, 2005

by Hanley Engineering, Inc.

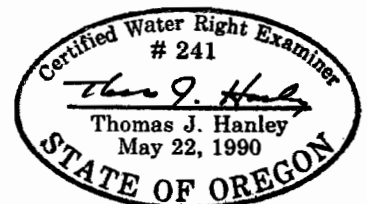

SEP 26 2005

WATER RESOURCES DEPT
SALEM, OREGON

HANLEY ENGINEERING, INC.
2043 MAIN STREET
BAKER CITY, OREGON