

CLAIM OF BENEFICIAL USE MAP
 LOCATED IN THE SE $\frac{1}{4}$ NE $\frac{1}{4}$ & NE $\frac{1}{4}$ SE $\frac{1}{4}$ OF SECTION 22
 TOWNSHIP 29 SOUTH, RANGE 11 WEST, W.M.
 COOS COUNTY, OREGON
 TRANSFER T-10783 CERTIFICATE 26280

LEGEND

POINT OF BEGINNING (P.O.B.)



POINT OF DIVERSION (P.O.D.)




PLACE OF USE (RESIDENCE)



PREPARED FOR: FRANK & LAUREN SPROUL

PREPARED BY: DENNIS GOUDE

DATE PREPARED: FEBRUARY 11, 2011

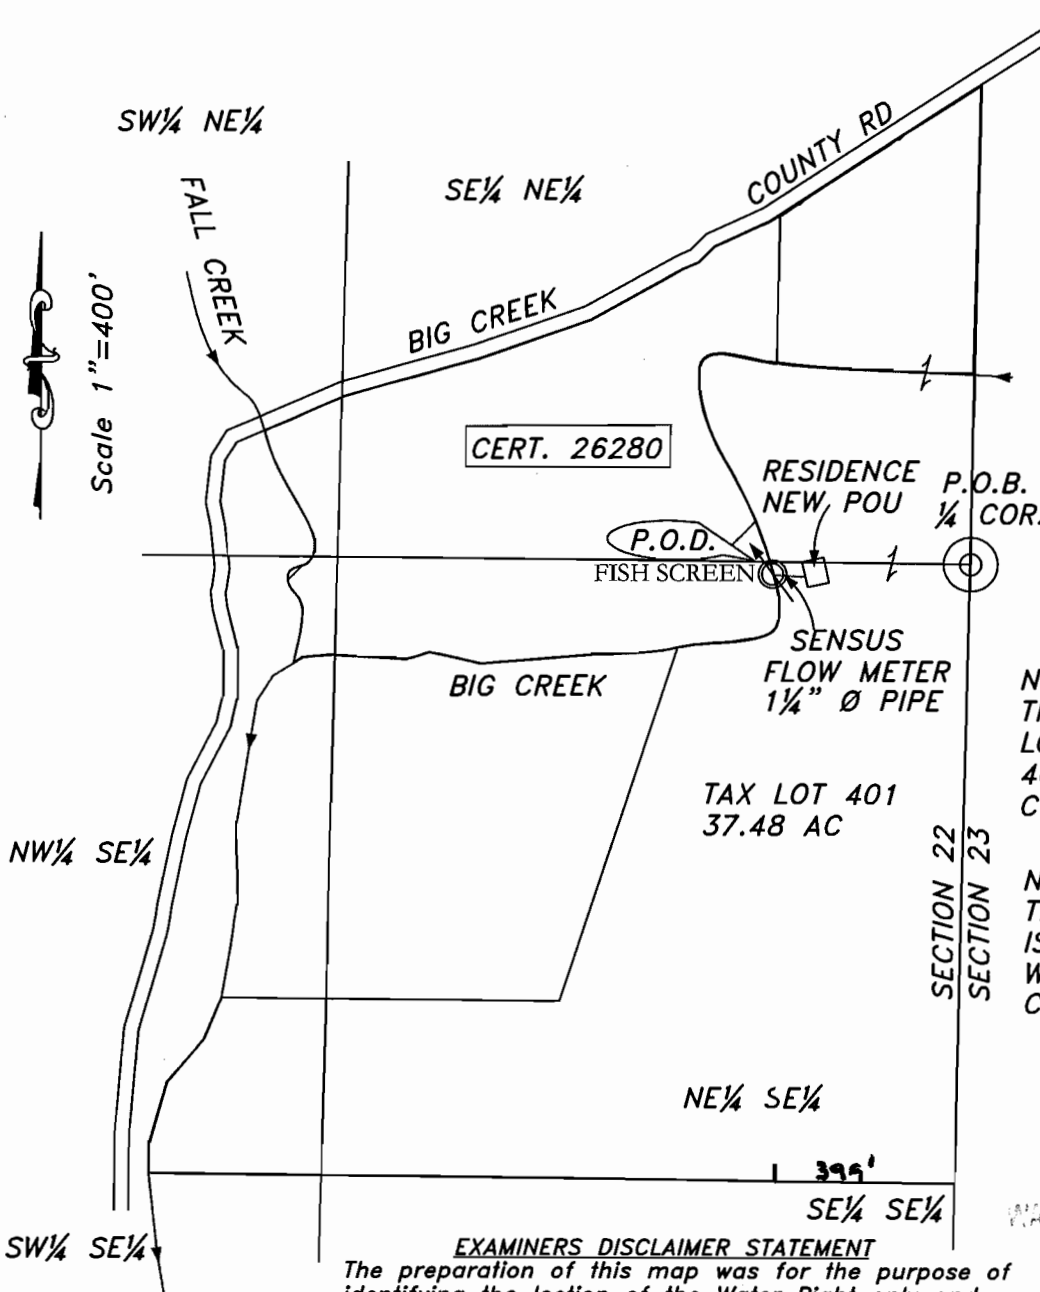

EXPIRES 12/31/2011

NOTE:
 THE POINT OF DIVERSION IS
 LOCATED SOUTH 88° WEST
 400 FEET FROM THE EAST $\frac{1}{4}$
 CORNER OF SECTION 22.

NOTE:
 THE NEW POU (RESIDENCE)
 IS LOCATED 340± FEET
 WSW FROM THE EAST $\frac{1}{4}$
 CORNER OF SECTION 22.

RECEIVED

MAR 04 2011

WATER RESOURCES DEPT

SALEM, OREGON
 Stantzer Engineering
 & Forestry, L.L.C.

ENGINEERING • LAND SURVEYING • FORESTRY
 PLANNING • WATER RIGHTS

706 South 4th St.
 Post Office Box 118
 Coos Bay, Oregon 97420 Phone: (541) 867-2872
 Fax: (541) 867-0888

EXAMINERS DISCLAIMER STATEMENT

The preparation of this map was for the purpose of
 identifying the location of the Water Right only and
 has no intent to provide dimensions or location of
 property ownership lines.