


RECEIVED

FEB 02 1999
WATER RESOURCES DEPT.
SALEM, OREGON

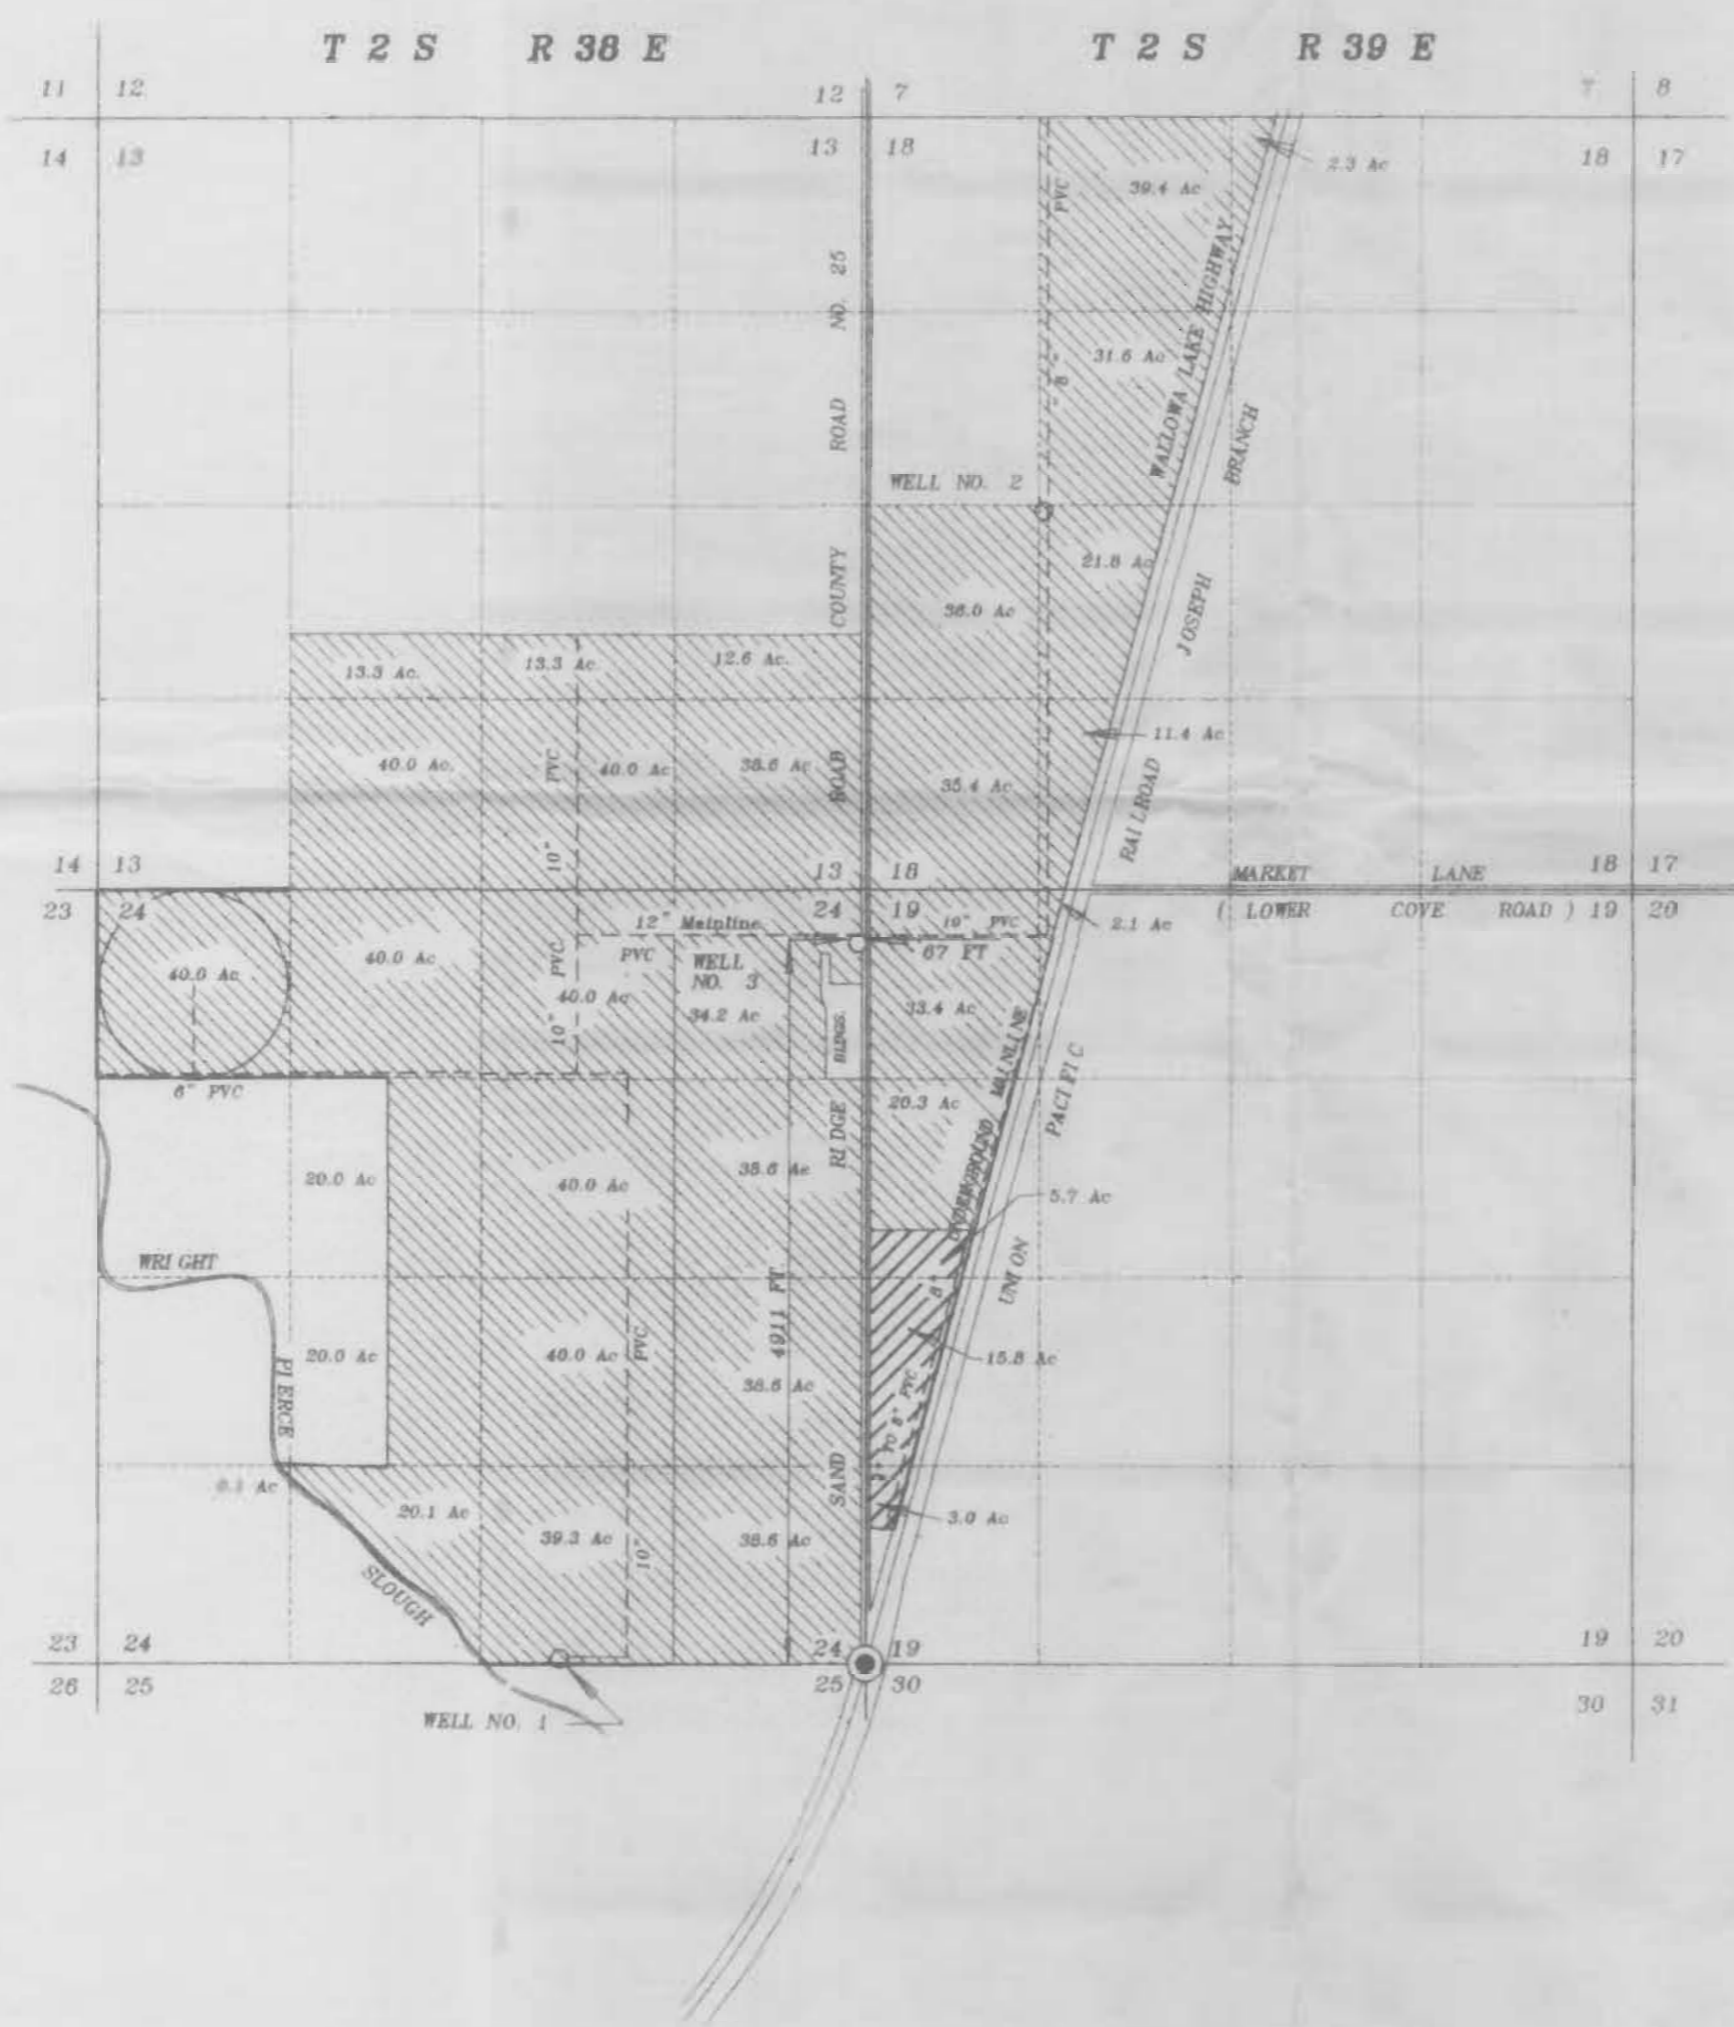


SCALE 1" = 1320'



LANDS REQUESTING SUPPLEMENTAL WATER FROM PROPOSED WELL NUMBER 3.



LANDS REQUESTING PRIMARY WATER FROM PROPOSED WELL NUMBER 3.

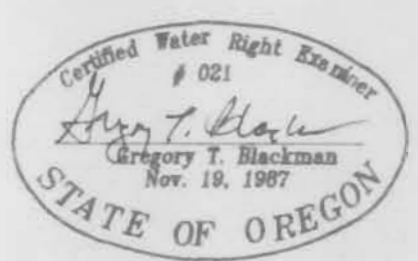

NOTE: The preparation of this map was for the purpose of identifying the location of the proposed water right and has no intent to provide dimensions or location of property ownership lines. Location information shown hereon was furnished by the applicant.

FINAL PROOF MAP OF
WATER RIGHTS
FOR

JOHN C. CUTHBERT &
DOROTHY JEAN CUTHBERT
BY
BAGETT - GRIFFITH & BLACKMAN
2006 ADAMS AVENUE
LAGRANDE, OREGON 97850

DECEMBER 15, 1998

APPLICATION NO. G- 3397
PERMIT NUMBER G- 12420