


SE 1/4 SEC. 29, T3N, R10W, W.M., TILLAMOOK COUNTY CLAIM OF BENEFICIAL USE MAP

UNDER APPLICATION NO. T-7046
IN THE NAME OF: MANZANITA GOLF COURSE, INC.
SURVEYED: MAY 22, 2007

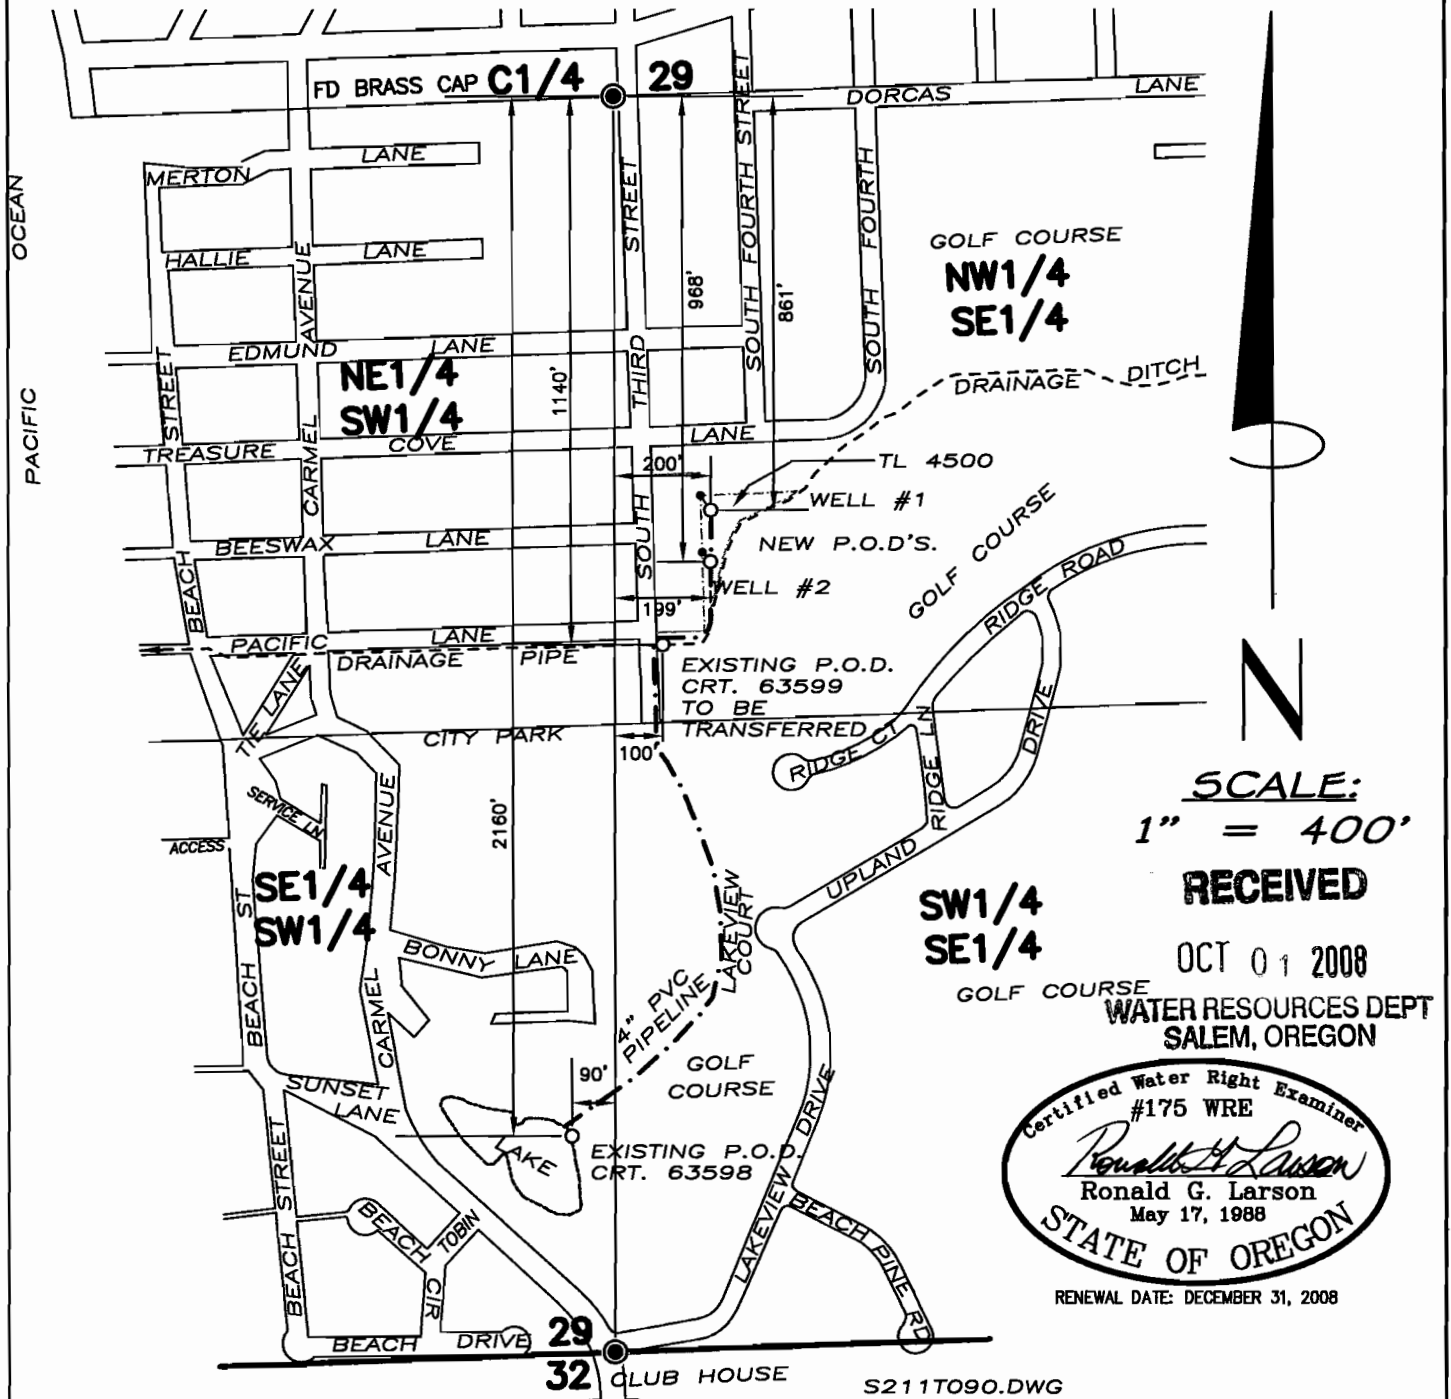

THE PURPOSE OF THIS MAP IS TO IDENTIFY THE LOCATION OF THE WATER RIGHT. IT IS NOT INTENDED TO PROVIDE INFORMATION RELATIVE TO THE LOCATION OF PROPERTY OWNERSHIP BOUNDARY LINES.

	<ul style="list-style-type: none"> • SURVEYING • CIVIL ENGINEERING • PLANNING • WATER RIGHTS • WETLAND CONSULTING 	PACIFIC COUNTY 1715-B N. PACIFIC AVE. LONG BEACH, WA 98631 (360) 642-4454 FAX: (360) 642-4054
	CLATSOP COUNTY 4253-A HWY 101 N. GEARHART, OR 97138 (503) 738-3425 FAX: (503) 738-7455	TILLAMOOK COUNTY 10445 NKN CREEK RD. MANZANITA, OR 97130 (503) 368-5394 FAX: (503) 368-5847

WWW.HLB-OTAK.COM